

NOTE: THE PREPARATION OF THIS MAP WAS FOR THE PURPOSE OF IDENTIFYING THE LOCATION OF THE PROPOSED WATER RIGHT, AND HAS NO INTENT TO PROVIDE DIMENSIONS OR LOCATIONS OF PROPERTY OWNERSHIP LINES.

RECEIVED BY DWRD

SEP 18 2002

SALEM, OR

POD - 1270' S. & 40' E OF THE NE COR SEC. 31

SCALE: 1" = 1320'


LEGEND

PIPELINE ———

FOUND BRASS CAP MONUMENT

POD POINT OF DIVERSION


T. 7 S., R. 24E.
T. 8 S., R. 24E.

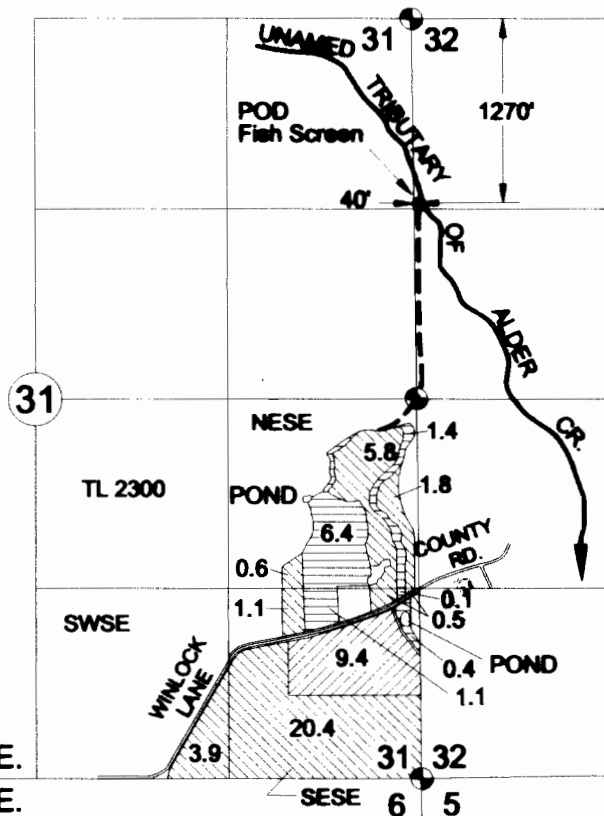

Final Proof Map
for
Water Right Transfer
T- 10804

-  9.4 AC. C54724 (1894)
-  9.4 AC. C82920 (1979)
-  34.1 AC. C82920 (Not part of Transfer)

for
Dorothy Roberta Hofer Vandehey
by

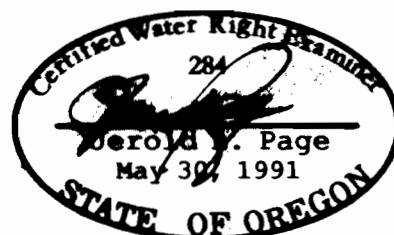

RENEW 12-31-12

7-21-12