

NOTE: THE PREPARATION OF THIS MAP WAS FOR THE PURPOSE OF IDENTIFYING THE LOCATION OF THE PROPOSED WATER RIGHT, AND HAS NO INTENT TO PROVIDE DIMENSIONS OR LOCATIONS OF PROPERTY OWNERSHIP LINES.

RECEIVED BY DWAD

SEP 18 2007

SALEM, OR



SCALE: 1" = 1320'

LEGEND


PIPELINE ————

FOUND BRASS CAP MONUMENT

POD POINT OF DIVERSION

T. 7 S., R. 24E.
T. 8 S., R. 24E.

POD - 1270' S. & 40' E OF THE NE COR SEC. 31

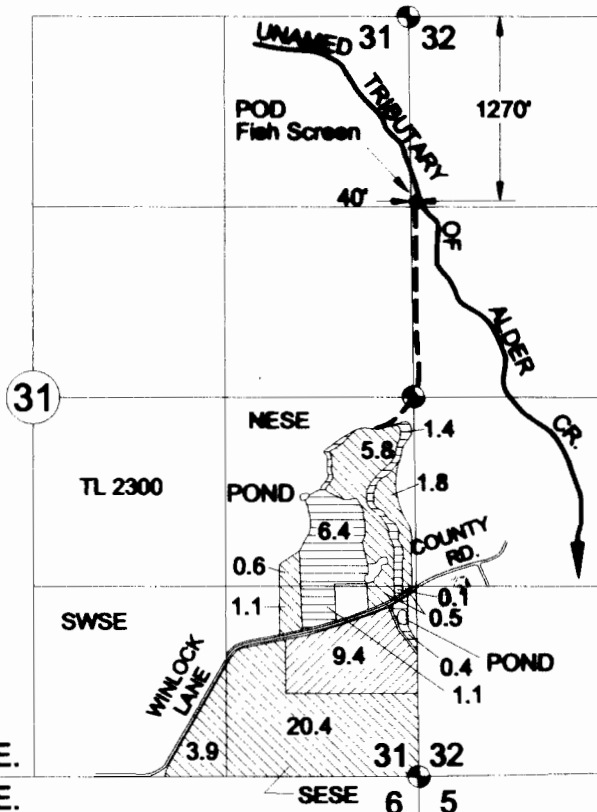

Final Proof Map
for
Water Right Transfer
T- 10804

-  9.4 AC. C54724 (1894)
-  9.4 AC. C82920 (1979)
-  34.1 AC. C82920 (Not part of Transfer)

for
Dorothy Roberta Hofier Vandehey
by



RENEW 12-31-12

7-21-12