



FINAL PROOF MAP

TO TRANSFER RIGHTS

FOR T-10796

MAX BOWEN


ALL WITHIN
SECTIONS 23 & 26, TOWNSHIP 27 SOUTH, RANGE 15 EAST, W.M.
TAX LOTS: 3700 AND 3702

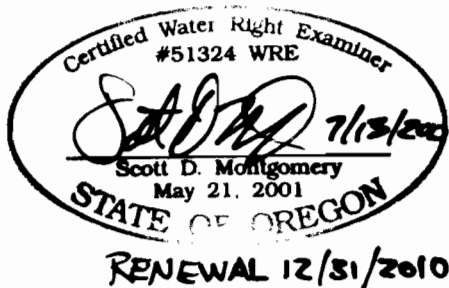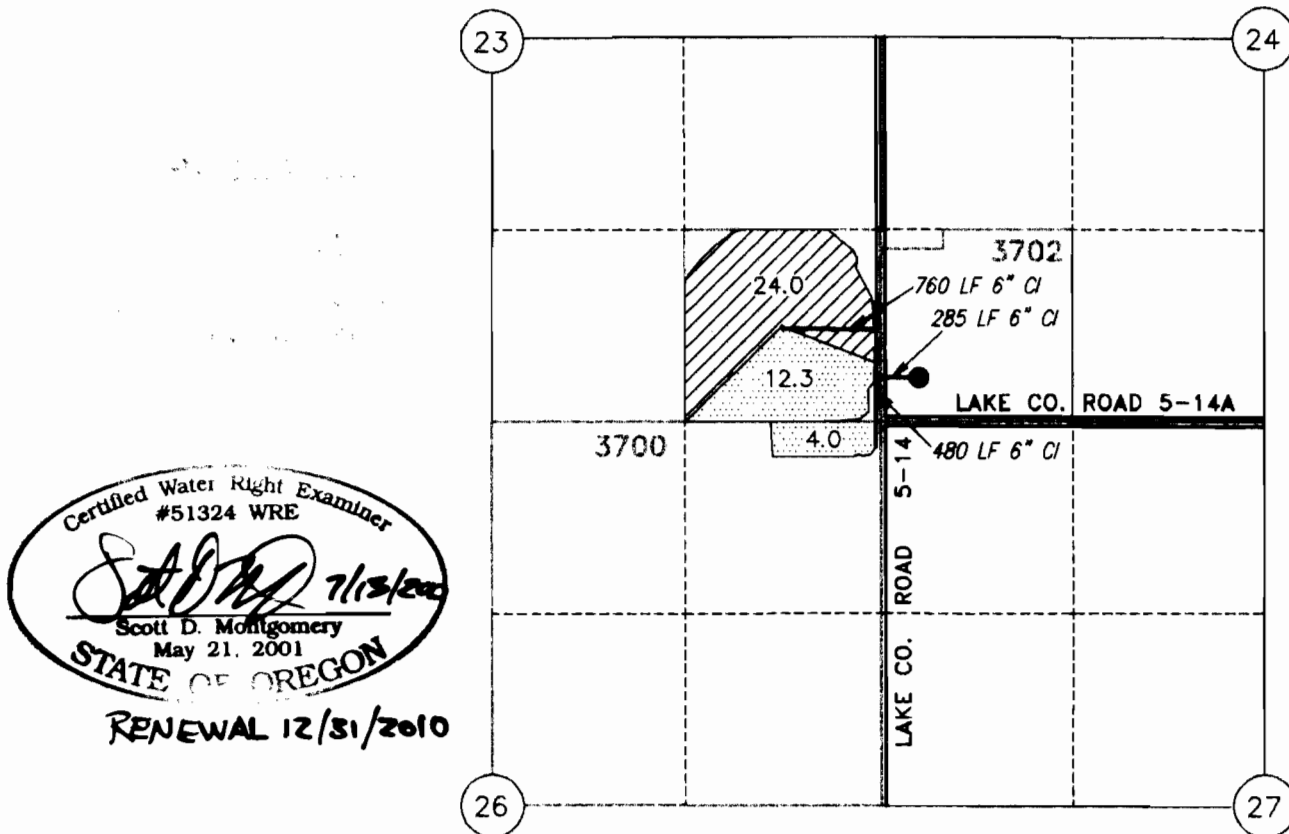


● POA LAKE 830

WELL IN THE SW1/4 OF THE SW1/4 OF SECTION 24
AND LOCATED 300 FEET NORTH AND 200 FEET EAST
FROM THE SOUTHWEST CORNER OF SECTION 24,
T27S R15E, W.M.

NEWLY INSTALLED METER IS APPROXIMATELY 5.5
FEET SOUTH ALONG DELIVERY PIPE FROM CENTER
PIVOT AND 648 FEET NORTH AND 679 FEET WEST
FROM THE SOUTHWEST CORNER OF SECTION 24,
T27S R15E, W.M..

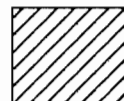

24.0 ACRES FROM U-410 (CERT.# 41932)
TRANSFERRED, AS SHOWN

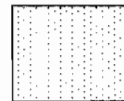

16.3 ACRES FROM G-10174 (CERT.# 65573)
TRANSFERRED, AS SHOWN

THIS MAP IS FOR THE PURPOSE OF LOCATING A WATER
RIGHT ONLY AND HAS NO INTENT TO PROVIDE LEGAL
DIMENSIONS OR THE LOCATION OF PROPERTY LINES

PREPARED FOR:

MAX BOWEN
56146 ARROW GAP ROAD
SILVER LAKE, OR 97638

PREPARED BY:



ALL POINTS ENGINEERING AND SURVEYING, INC.
P.O. BOX 767 (CRR) TERREBONNE, OR 97760
(541) 548-5833
www.APEandS.com