

RECEIVED BY OWRD


# Claim of Beneficial Use

## T-10668



### Tax Lots 2800, 3002, 3003, Map 15-11

SEP 17 2012

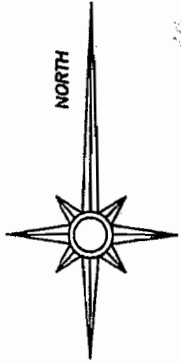


SALEM, OR

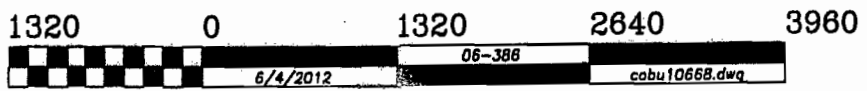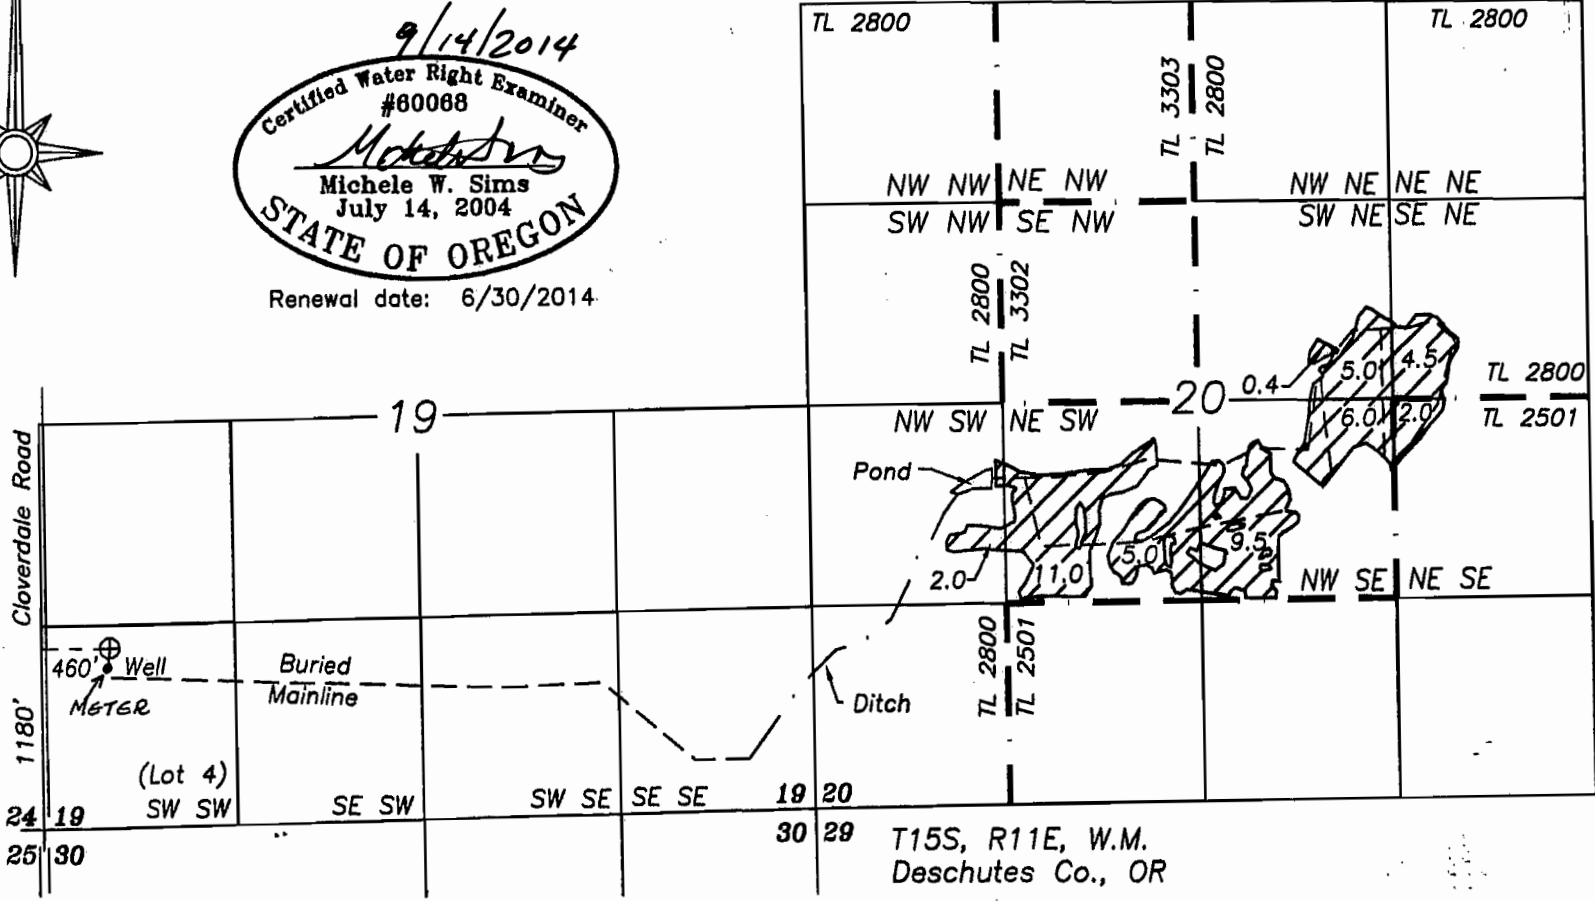

Renewal date: 6/30/2014



GRAPHIC SCALE - FEET

-  Water used beneficially under T-10668
-  Mainline
-  Ditch

THIS MAP IS FOR THE PURPOSE OF IDENTIFYING THE LOCATION OF THE WATER RIGHT. IT IS NOT INTENDED TO PROVIDE LEGAL DIMENSIONS OR LOCATIONS OF PROPERTY OWNERSHIP LINES.