



FINAL PROOF SURVEY
AND
CLAIM OF BENEFICIAL USE
ADDITIONAL POINT OF APPROPRIATION

LOCATED WITHIN
NE 1/4, NE 1/4, SECTION 26, T.6N., R.34E., W.M
UMATILLA COUNTY, OREGON
TRANSFER 7920 SPECIAL ORDER VOLUME 52, PAGE 914
APPLICANT: DON M. MARLATT

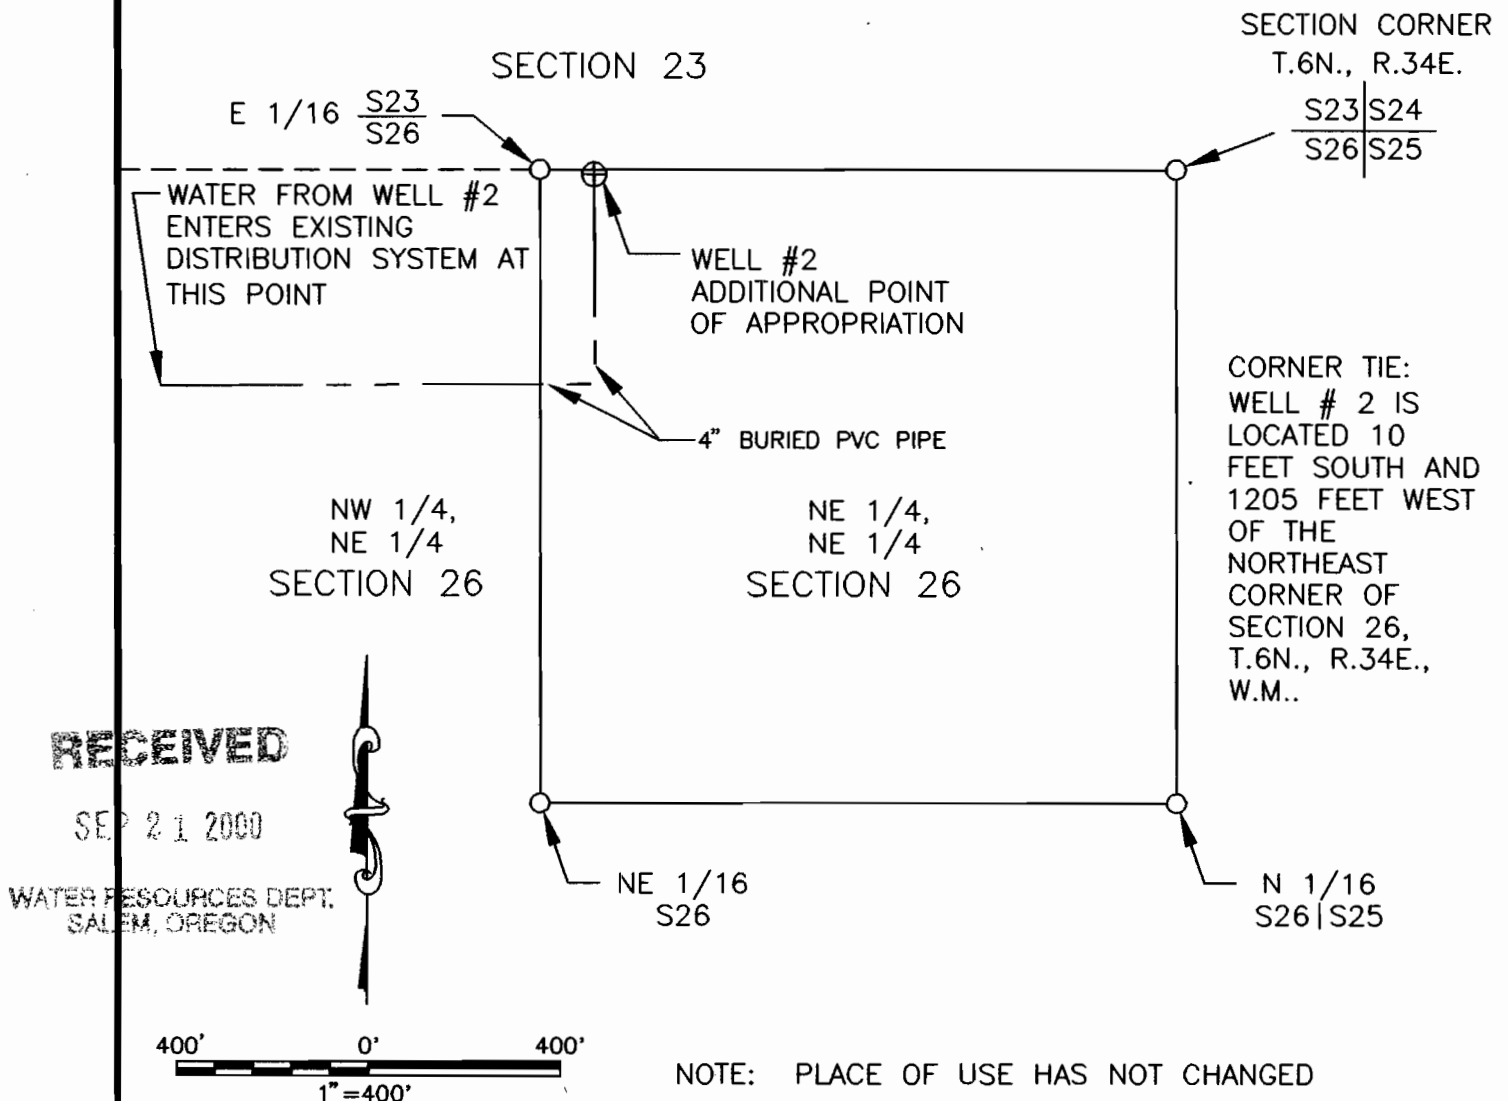

THIS MAP IS PREPARED
FOR THE EXPRESS
PURPOSE TO SHOW WATER
APPROPRIATION AND USE.
IT IS NOT INTENDED TO
SHOW OR LOCATE
PROPERTY OWNERSHIP
LINES.

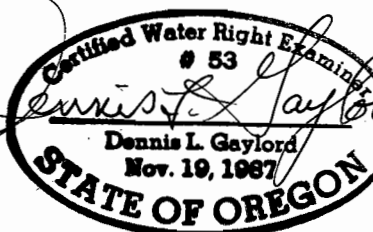

RENEWS 6/30/2001

DENNIS L. GAYLORD,
CWRE
71614 S.W. LAKE DRIVE
PENDLETON, OR 97801
(541)-276-6260 ©
JUNE, 2000
Drawn by: Mill Creek Drafting