

TRANSFER T-10099 CLAIM MAP

T3S. R1E., W.M.
CLACKAMAS COUNTY, OREGON
SE 1/4 AND NE 1/4 SECTION 8

RECEIVED
AUG 20 2011
CLACKAMAS COUNTY
SALMON, OREGON

P.O.U. - PLACE OF IRRIGATION USE
BY ACRES BY 1/4 -1/4

SECTION 8

SW 1/4 NE 1/4 - 1.3 AC
SE 1/4 NE 1/4 - 13.3 AC
NE 1/4 SE 1/4 - 2.2 AC
NW 1/4 SE 1/4 - 0.2 AC
TOTAL = 17.0 AC

PREPARATION OF THIS MAP IS FOR THE
PURPOSE OF IDENTIFYING THE LOCATION OF
THE WATER RIGHT ONLY. THERE IS NO
INTENT TO PROVIDE DIMENSIONS OR
LOCATION OF PROPERTY OWNERSHIP LINES.

LEGEND


"TO" ACRES IRRIGATED



WELL (CLAC-63540)



VALVE

 

IRRIGATION PIPING



USGS GRID



PROPERTY LINE

NOTES:

COORDINATES OF WELL (CLAC-63540):
809 FEET SOUTH AND 801 FEET WEST
FROM NE CORNER SECTION 8.

SPRINKLERS CONNECTED TO THE 6-INCH
PVC LOOP IRRIGATE THE PERIMETER OF
THE CHAMPIONSHIP FIELD. A TRAVELLING
WATER-GUN IRRIGATES THE INTERIOR.

SURVEY

AND CLAIM OF BENEFICIAL USE
TRANSFER T-10099


IN THE NAME OF

MURRAY-JENKINS I, LLC

FOR

IRRIGATION FROM A WELL
IN THE NEWLAND CREEK BASIN,
TRIBUTARY TO THE WILLAMETTE RIVER
SURVEYED AUGUST 23, 2011
BY JOHN E. BORDEN, CWRE

SCALE: 1"=400'

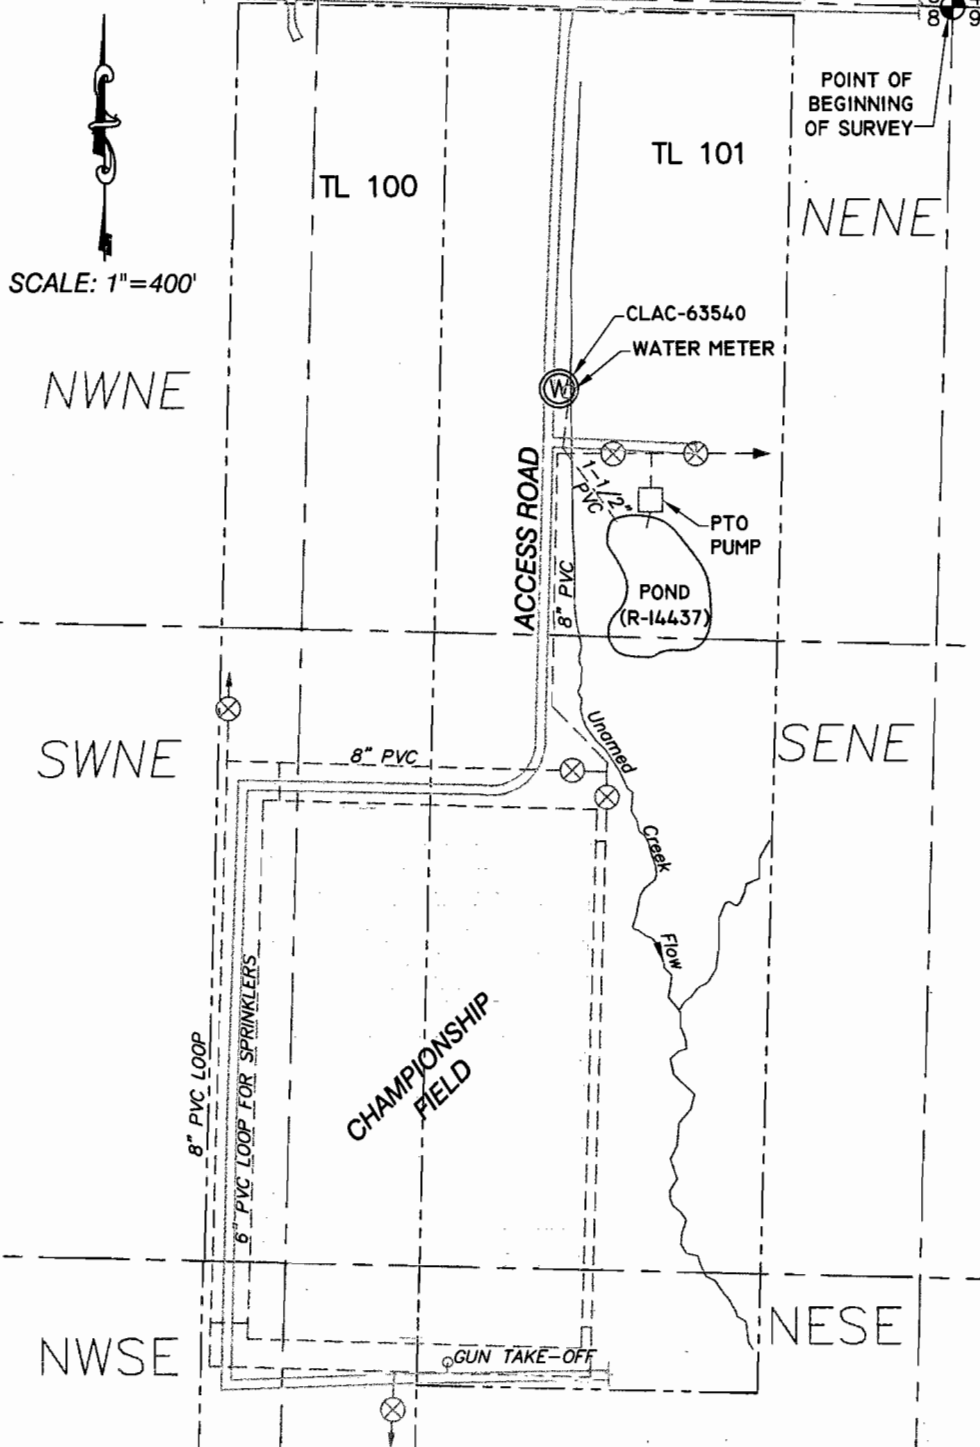

JOHN BORDEN CONSULTING

5597 RIVER STREET
WEST LINN, OR. 97068
503-723-4257

COBU MAP

FILE PATH & NAME: D:\SCHNELL\POLO FIELDS WR 101411.dwg