

FINAL PROOF SURVEY

UNDER

TRANSFER 7925

IN NAME OF


GREG TOMLINSON

Surveyed Sept. 17, 1999

RECEIVED

SEP 30 1999

WATER RESOURCES DEPT.
SALEM, OREGON

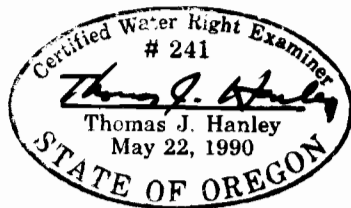

SCALE 1" = 400'

THE PURPOSE OF THIS MAP IS FOR IDENTIFYING THE LOCATION OF THE WATER
RIGHT ONLY AND IS NOT INTENDED TO PROVIDE LEGAL DIMENSIONS OF PROPERTY
OWNERSHIP LINES.

T. 8S., R. 42E., W.M.

13

