

RECEIVED BY OWRD

# FINAL PROOF SURVEY


SEP 17 2012

Ron and Joyce Dowdy Trust

Transfer No. 9590

SALEM, OR

Township 13 South, Range 28 East, Sections 8 & 17 W.M.

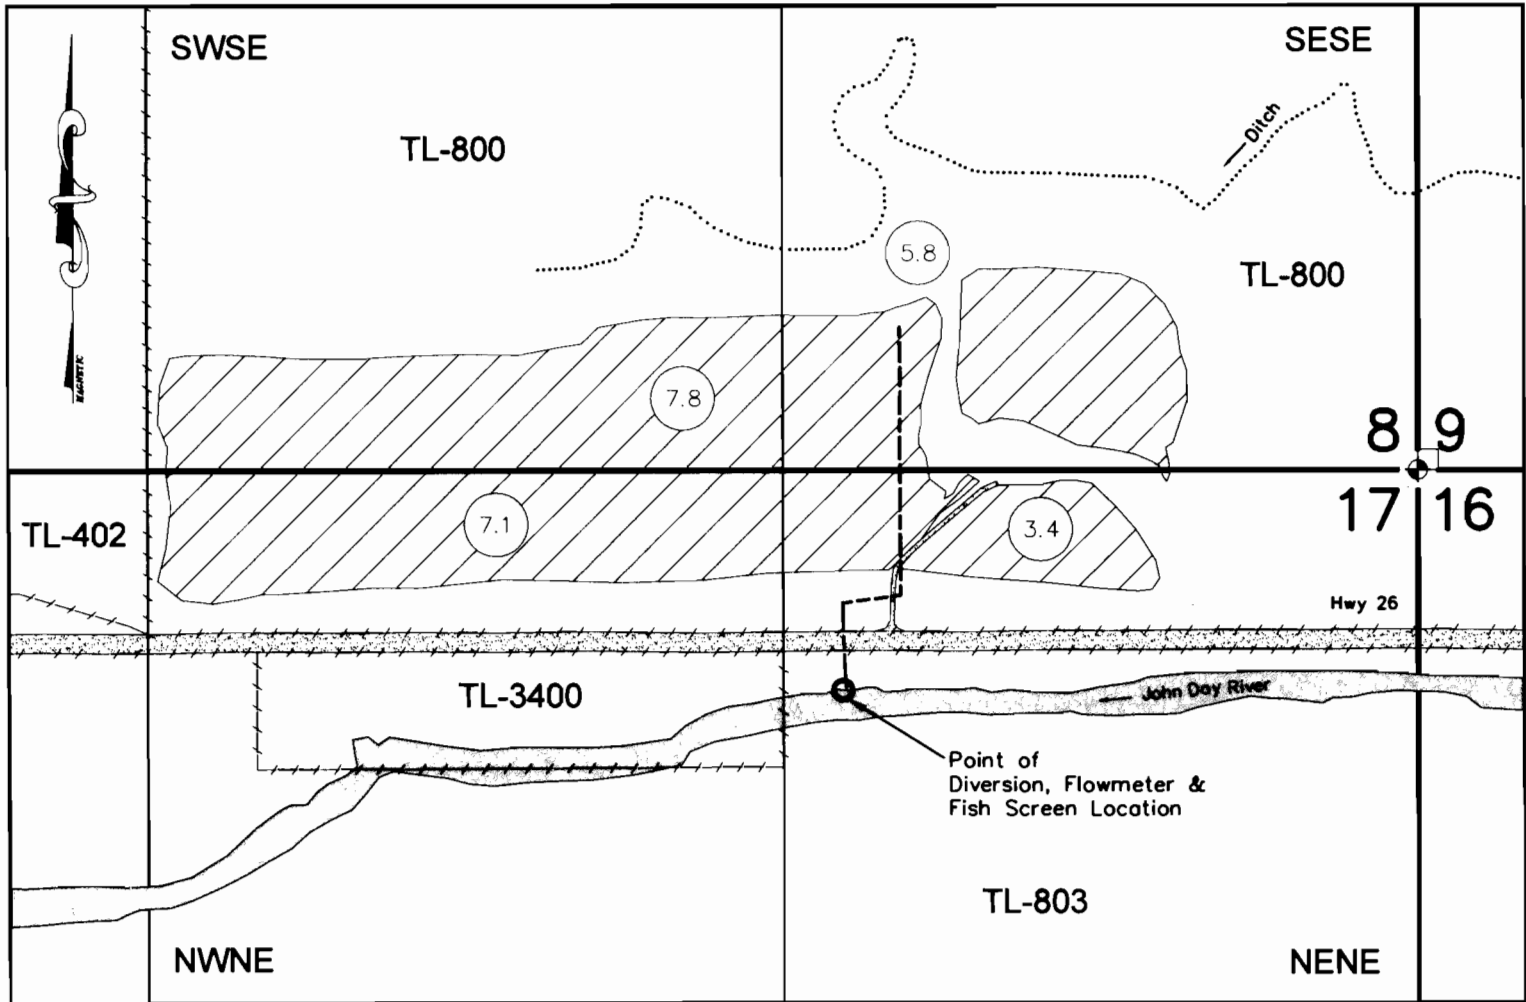



## LEGEND

- Located Section Corner
- Ditch and Laterals
- Irrigation Pipeline
- Property Ownership Line
- Lands Irrigated under T-9590

Irrigated Acres

2.3

Scale: 1" = 400'

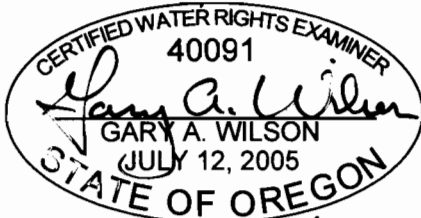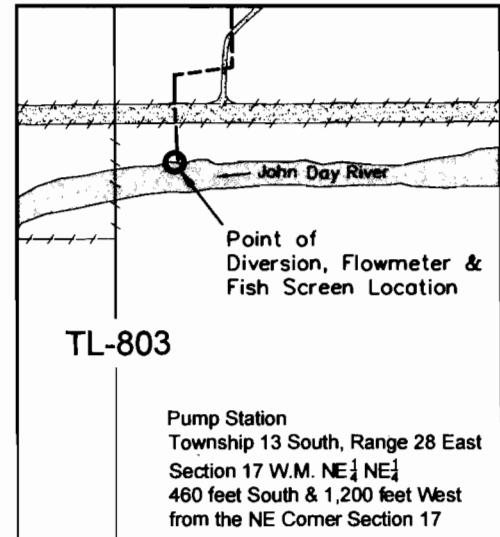

Expires: 6/30/2014

This map is not intended to provide legal dimensions or location of property ownership lines.

RECEIVED BY OWRD

# FINAL PROOF SURVEY


Ron and Joyce Dowdy Trust

SEP 17 2012

Transfer No. 9590


SALEM, OR

Township 13 South, Range 28 East, W.M.

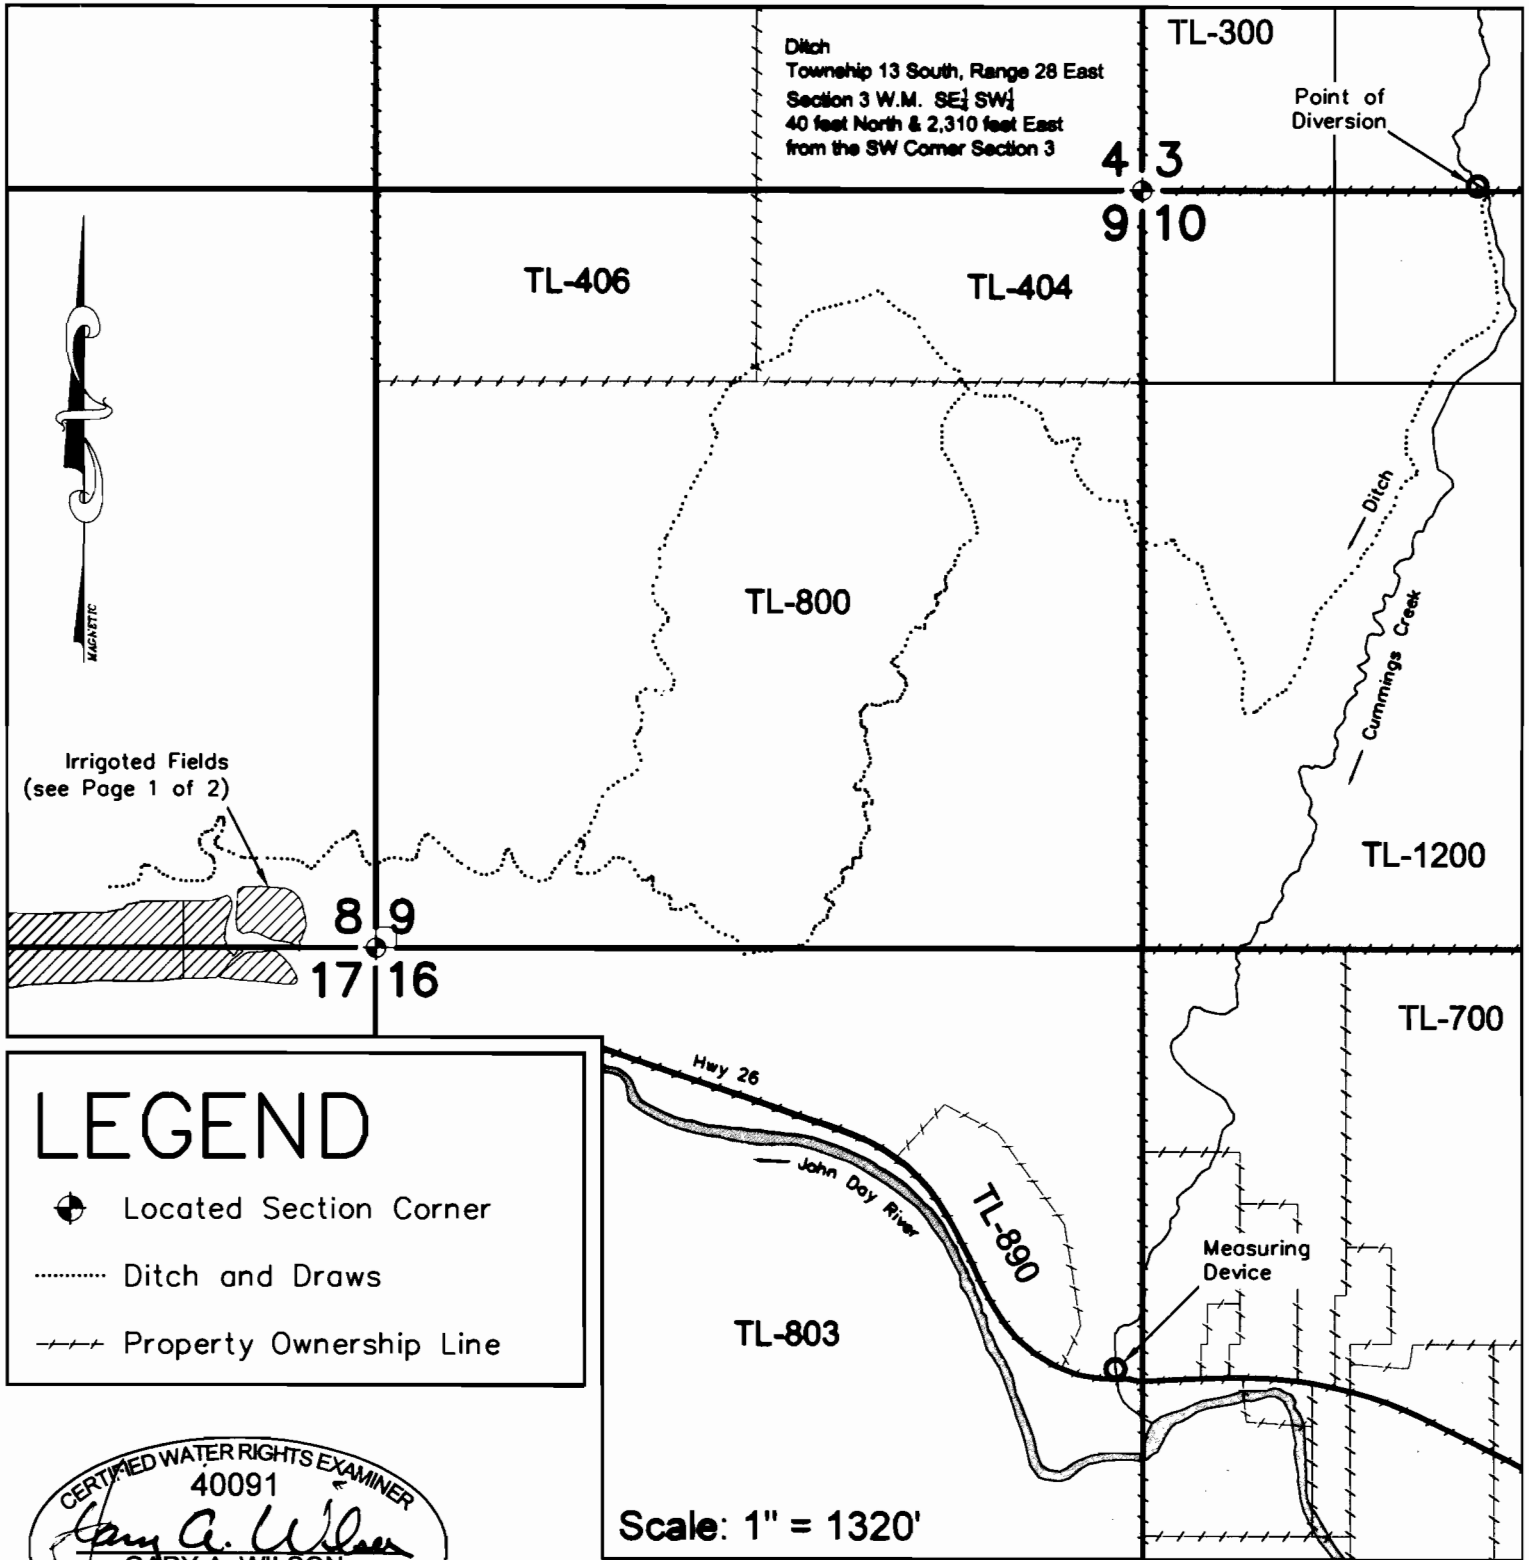

## LEGEND

- Located Section Corner
- ..... Ditch and Draws
- - - - Property Ownership Line

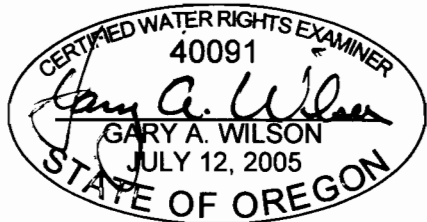

EXPIRES: 6/30/2014

This map is not intended to provide legal dimensions or location of property ownership lines.