
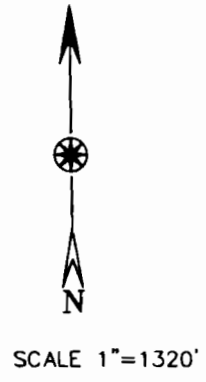


MAP TO ACCOMPANY CLAIM OF BENEFICIAL USE
TRANSFER T-8306 CHANGE IN POINT OF DIVERSION

FOR

MARVIN L. AND MARTHA J. GINSBURG
T.31&32S. R.3W.W.M.

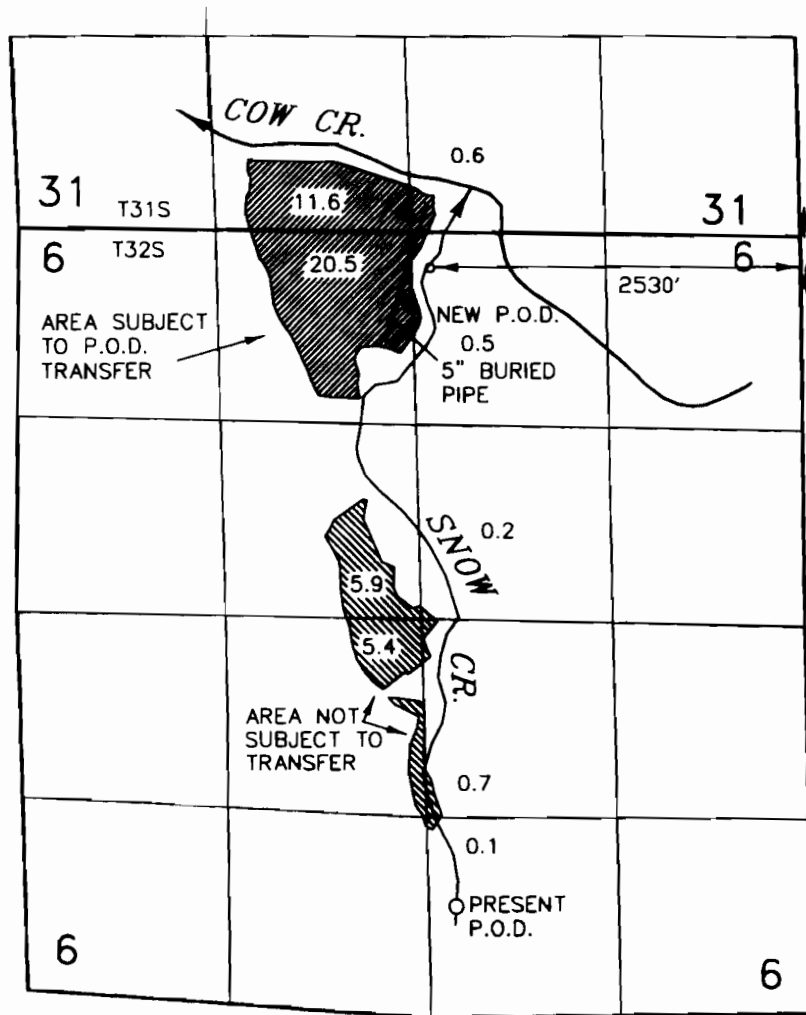

THIS MAP IS TO BE USED FOR WATER RIGHT PURPOSES ONLY

PRESENT P.O.D. FOR
REMAINING LAND.
RECORD LOCATION
4580' S. AND
2430' W. FROM
NE COR. S. 6,
T32S, R3W WM

RECEIVED

APR 28 2002

WATER RESOURCES DEPT
SALEM, OREGON

Certified Water Right Examiner
#115 WRE
William J. Ruppert
William J. Ruppert
Nov. 19, 1987
STATE OF OREGON

EXPIRES 12-31-2002

EXISTING WATER RIGHT
PERMIT NO. 25833
CERT. NO. 37097
IN NAME OF HERBERT JONES, JR.

BY: WILLIAM J. RUPPERT
P.O. BOX 1564
MYRTLE CREEK, OR 97457

INSPECTED JUNE 31, 2001