

CLAIM OF BENEFICIAL USE  
 FOR: DANA AND MARALEE WESTBROOK  
 By: DUANE W. KIRBY  
 T25S, R6W, SEC 12 WM  
 TAX LOT 302  
 PERMIT NO T-10085  
 FISH SCREEN IS AT THE POD  
 METER IS LOCATED 50 FEET FROM POD  
 SCALE 1" = 1320'


RECEIVED

OCT 23 2009

WATER RESOURCES DEPT  
 SALEM, OREGON

PLACE OF USE  
 POND MAINTENANCE

CALAPOOYA CREEK

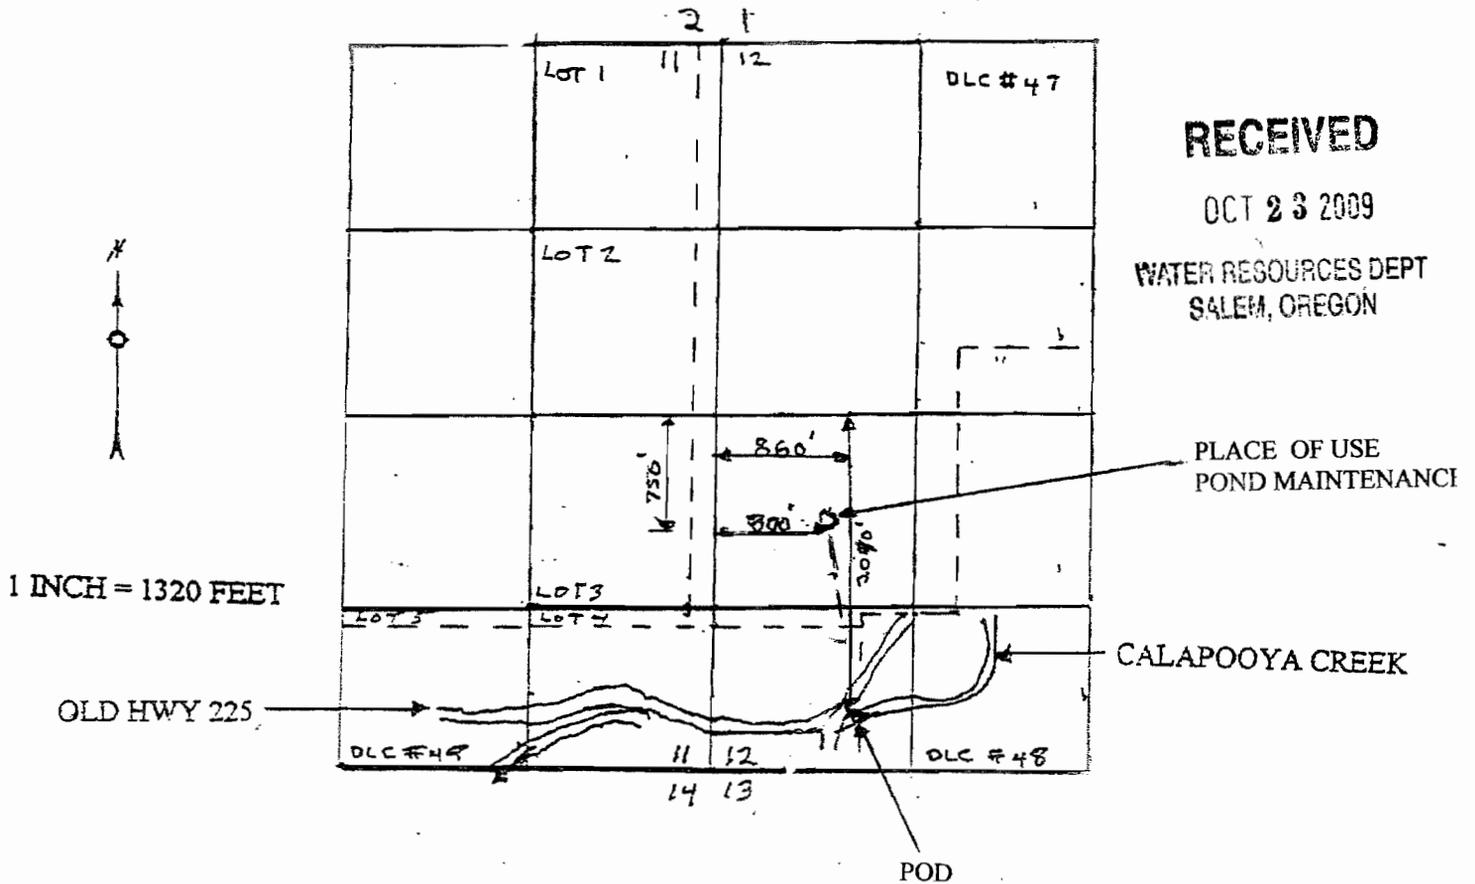

THE PURPOSE OF THIS MAP IS TO IDENTIFY THE LOCATION OF THE WATER RIGHT. IT IS NOT INTENDED TO PROVIDE INFORMATION RELATIVE TO THE LOCATION OF PROPERTY OWNERSHIP BOUNDARY LINES.

