

**SCALE: 1"=1320'**


RECEIVED BY OWRD

SEP 24 2012

SALEM, OR



Lands changing the character of use from Irrigation and Supplemental Irrigation to Primary Commercial use including the irrigation of a Golf Course, and cancelling the underlying primary right under Certificate No. 6495.

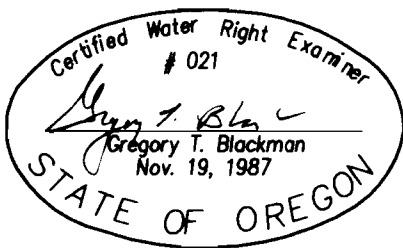

NOTE: The preparation of this map was for the purpose of identifying the location of the proposed water right and has no intent to provide dimensions or location of property ownership lines. Location information shown hereon was furnished by the applicant.

August 5, 2012

FINAL PROOF FOR A CHANGE IN CHARACTER OF USE AND PARTIAL CANCELLATION OF A WATER RIGHT

FOR  
LA GRANDE COUNTRY CLUB  
BY  
BAGETT-GRIFFITH & BLACKMAN  
2006 ADAMS AVENUE  
LA GRANDE, OREGON 97850

Application No. T-10046

Permit No. \_\_\_\_\_