

RECEIVED



T.36S.,R.1W.,W.M.

SHEET 2 OF 4

APR 26 1999

WATER RESOURCES DEPT.  
SALEM, OREGON

SECTION COR.

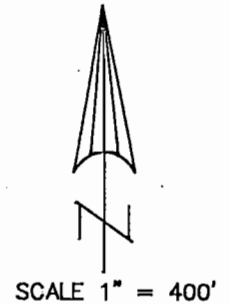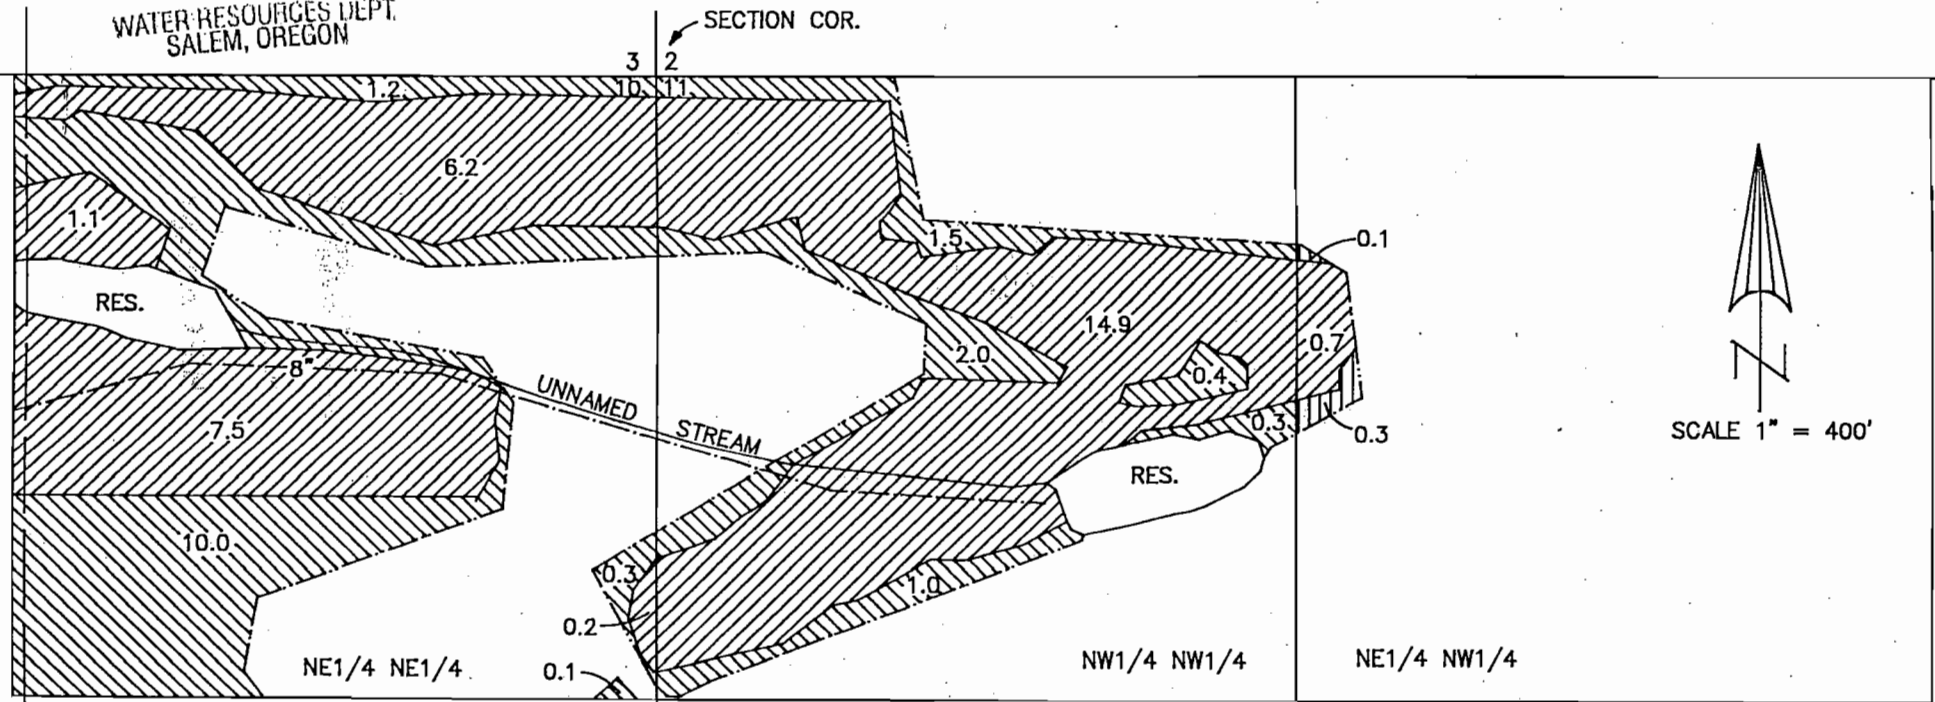

EAST BOUNDARY  
D.L.C. NO. 47




### FINAL PROOF MAP

APPLICATION No. T-7660, T-7661,  
T-7662, T-7663 & T-7664


IN THE NAME OF  
EAGLE POINT GOLF CLUB, L.L.C.

NOTE: 1. MAP PREPARED FOR  
WATER RIGHT PURPOSES ONLY,  
NOT FOR PROPERTY BOUNDARY  
LOCATIONS.

2. FOR POINT OF DIVERSION  
T-7664 SEE SHEET 1 OF 4

-  = Cert. 75429 (EPID, No Change)
-  = T-7662 (EPID)
-  = T-7664 (Little Butte Irrigation Co.)

MAP PREPARED MARCH 1, 1999 BY GARY D. KAISER

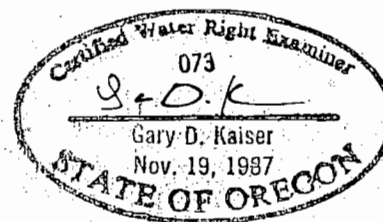

SW1/4 SW1/4

T.36S.,R.1W.,W.M.


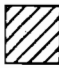

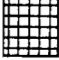
RECEIVED


APR 26 1999

WATER RESOURCES DEPT.  
SALEM, OREGON



SCALE 1" = 400'

-  = T-7662 (EPID)
-  = Cert. 75427 (No change from Permit No. 15987)
-  = Cert. 72476 (No change from Permit No. 17621)
-  = T-7661

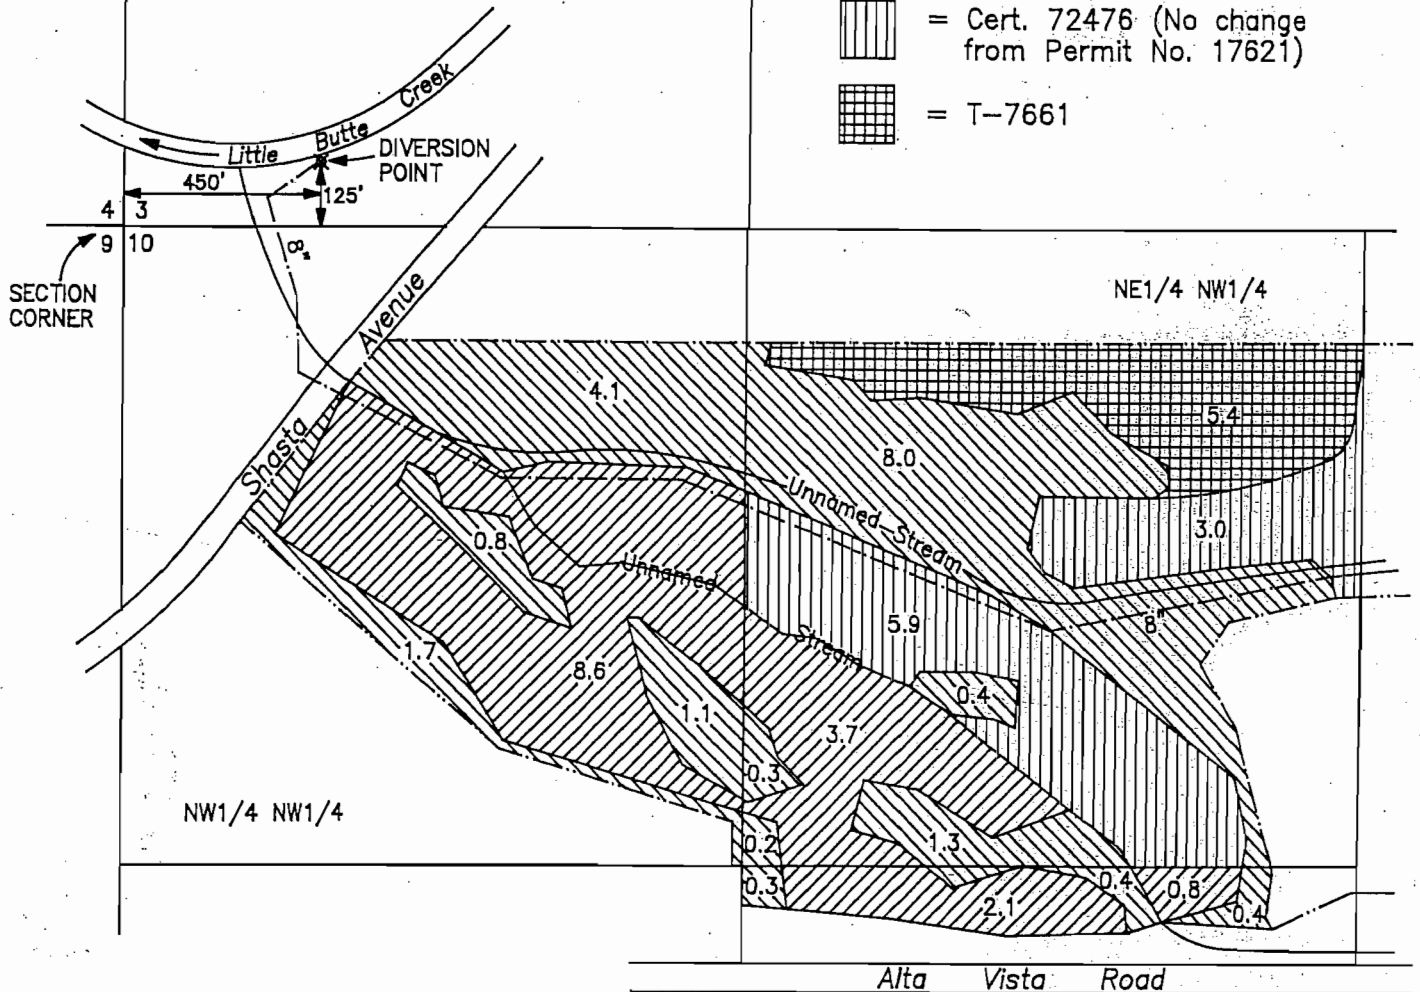

FINAL PROOF MAP

APPLICATION No. T-7660, T-7661,  
T-7662, T-7663 & T-7664

IN THE NAME OF  
EAGLE POINT GOLF CLUB, L.L.C.

MAP PREPARED MARCH 1, 1999  
BY GARY D. KAISER

SE1/4 NW1/4

NOTE: MAP PREPARED FOR  
WATER RIGHT PURPOSES ONLY,  
NOT FOR PROPERTY BOUNDARY  
LOCATIONS.

