
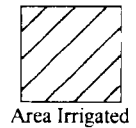


T.5S., R.5W., W.M.

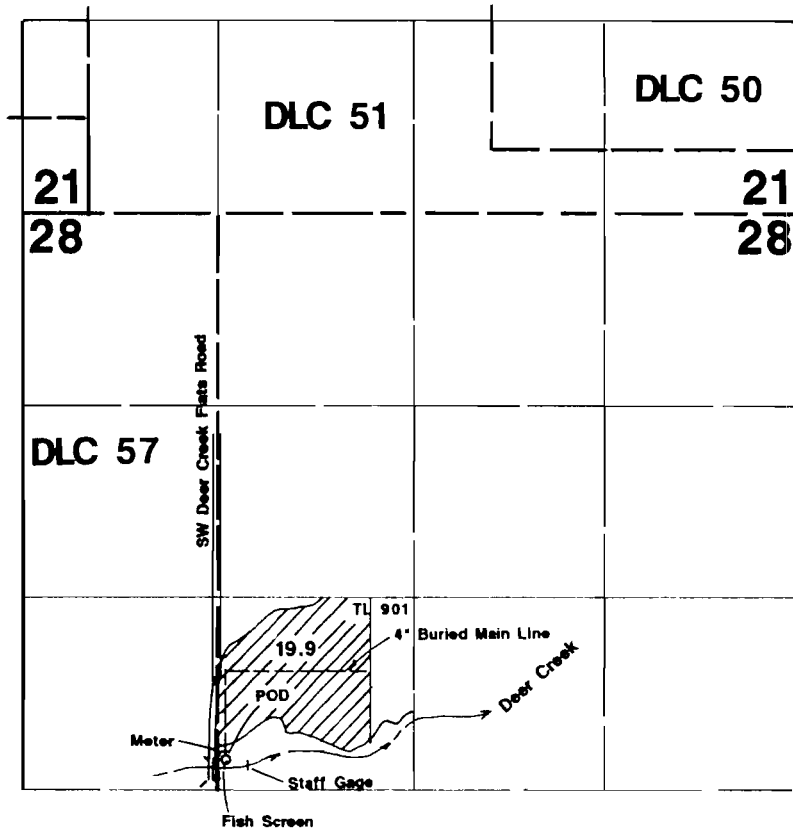

POD is located 3760' S & 3860' W from the NE corner of Section 28.

Final Proof Survey

In the Name of

Jerry Freeman

Transfer #: T-9831

Surveyed on January 25, 2009 by JM Schuette

This Map was Prepared for the Purpose of Identifying the Location of a Water Right Only and is Not Intended to Provide Legal Dimensions or Location of Property Ownership Lines.

