

IN SE.1/4 OF SW.1/4, SECTION 32, TOWNSHIP.1 S. RANGE 13 E. W.M.
 WASCO COUNTY, OREGON

RECEIVED

FEB 16 2005

WATER RESOURCES DEP.
 SALEM, OREGON

THIS 5.6 AC. NOW IN C.R.P. WASCO
 COUNTY FARM SERVICES AGENCY,
 CONTRACT #455, TRACT T246

CERTIFICATE No. T-9565


PERMIT No. _____

IN THE NAME OF:
EUGENE UNDERHILL

DATE: JANUARY 11, 2005

BY: **TENNESON ENGINEERING CORP.**


409 LINCOLN STREET,
 THE DALLES, OREGON. 97058
 PH. (541) 296-9177
 FAX (541) 296-6657

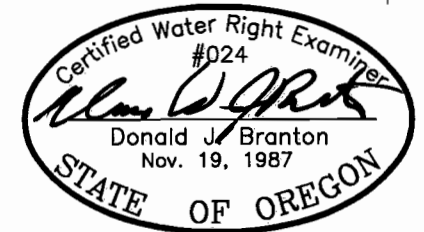

RENEW: 12/31/05

NOTE:

"THIS MAP IDENTIFIES THE LOCATION OF
 THE WATER RIGHT ONLY AND IS NOT
 INTENDED TO PROVIDE DIMENSIONS OR
 LOCATE PROPERTY OWNERSHIP LINES."

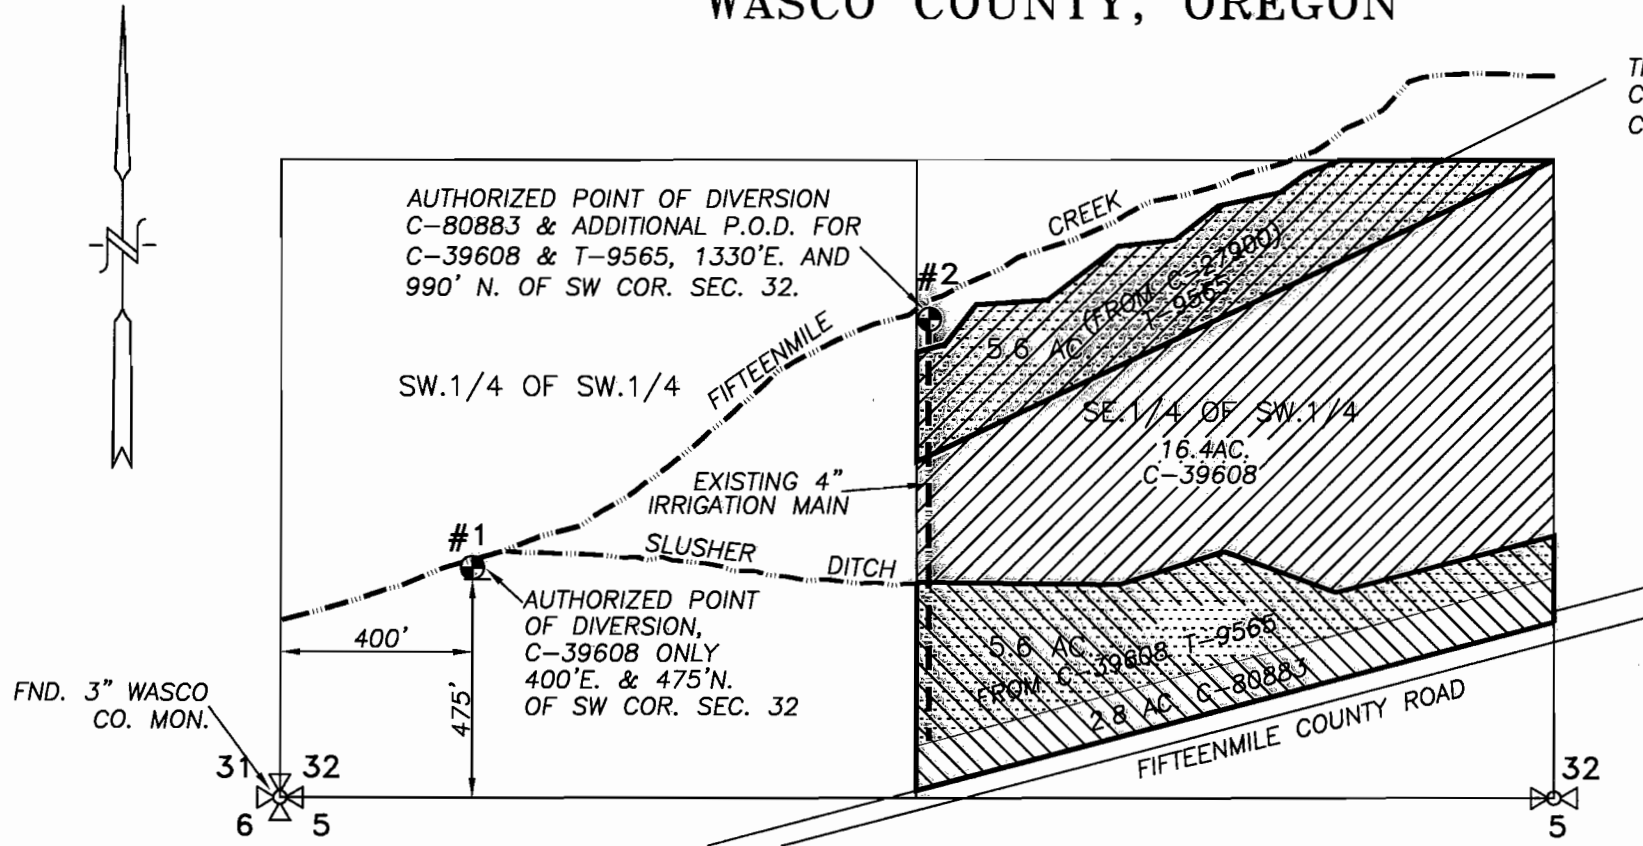

AUTHORIZED POINT OF DIVERSION
 C-80883 & ADDITIONAL P.O.D. FOR
 C-39608 & T-9565, 1330'E. AND
 990' N. OF SW COR. SEC. 32.

SW.1/4 OF SW.1/4

AUTHORIZED POINT
 OF DIVERSION,
 C-39608 ONLY
 400'E. & 475'N.
 OF SW COR. SEC. 32

FND. 3" WASCO
 CO. MON.

- PRIOR CERTIFICATE 27900, REISSUED C-80883 (2.8 + 5.6 = 8.4 AC.)
- EXISTING CERTIFICATE 39608 (16.4 + 5.6 = 22.0 AC.) T-9565
- AREA EXCHANGED (5.6 AC)

----- EXISTING 4" IRRIGATION MAIN

WATER RIGHT CLAIM OF BENEFICIAL USE

TRANSFER & ADDITIONAL POINT OF DIVERSION

SCALE: 1" = 400'

W.O. #10813