

FINAL PROOF SURVEY MAP

TAX LOTS 1500 & 1700

Permit S-49188; White Butte Ranch POU

Located in SE-SW & SW-SE of Section 6 and

Located in NE-NW & SE-NW of Section 7 and

Located in SW-SW of Section 8 and

Located in NW-NW, NE-NW, SE-NW, & SW-NW of Section 17



T.12S., R.21E., W.M. - Wheeler County, Oregon

NOTES

1. This map was prepared for the purpose of identifying the location of water rights only and is not intended to provide legal dimensions or locations of property ownership lines.
2. This map was prepared by Newton Consultants, Inc. based on OWRD file notes for Final Proof Survey, conducted by OWRD staff on May 14, 2001.




Summary Table of Irrigation

Section 6			
Tax Lot #	Qtr-Qtr	Acres	Totals
1500	SE-SW	6.3	6.5
	SW-SE	0.2	
Section 7			
Tax Lot #	Qtr-Qtr	Acres	Totals
1500	NE-NW	2.2	16.5
	SE-NW	14.3	
Section 8			
Tax Lot #	Qtr-Qtr	Acres	Totals
1700	SW-SW	9.8	9.8
Section 17			
Tax Lot #	Qtr-Qtr	Acres	Totals
1700	NW-NW	9.5	17.2
	NE-NW	6.0	
	SE-NW	0.1	
	SW-NW	1.6	
		Total:	50.0

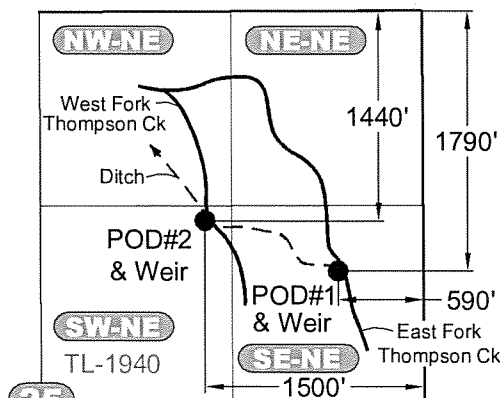
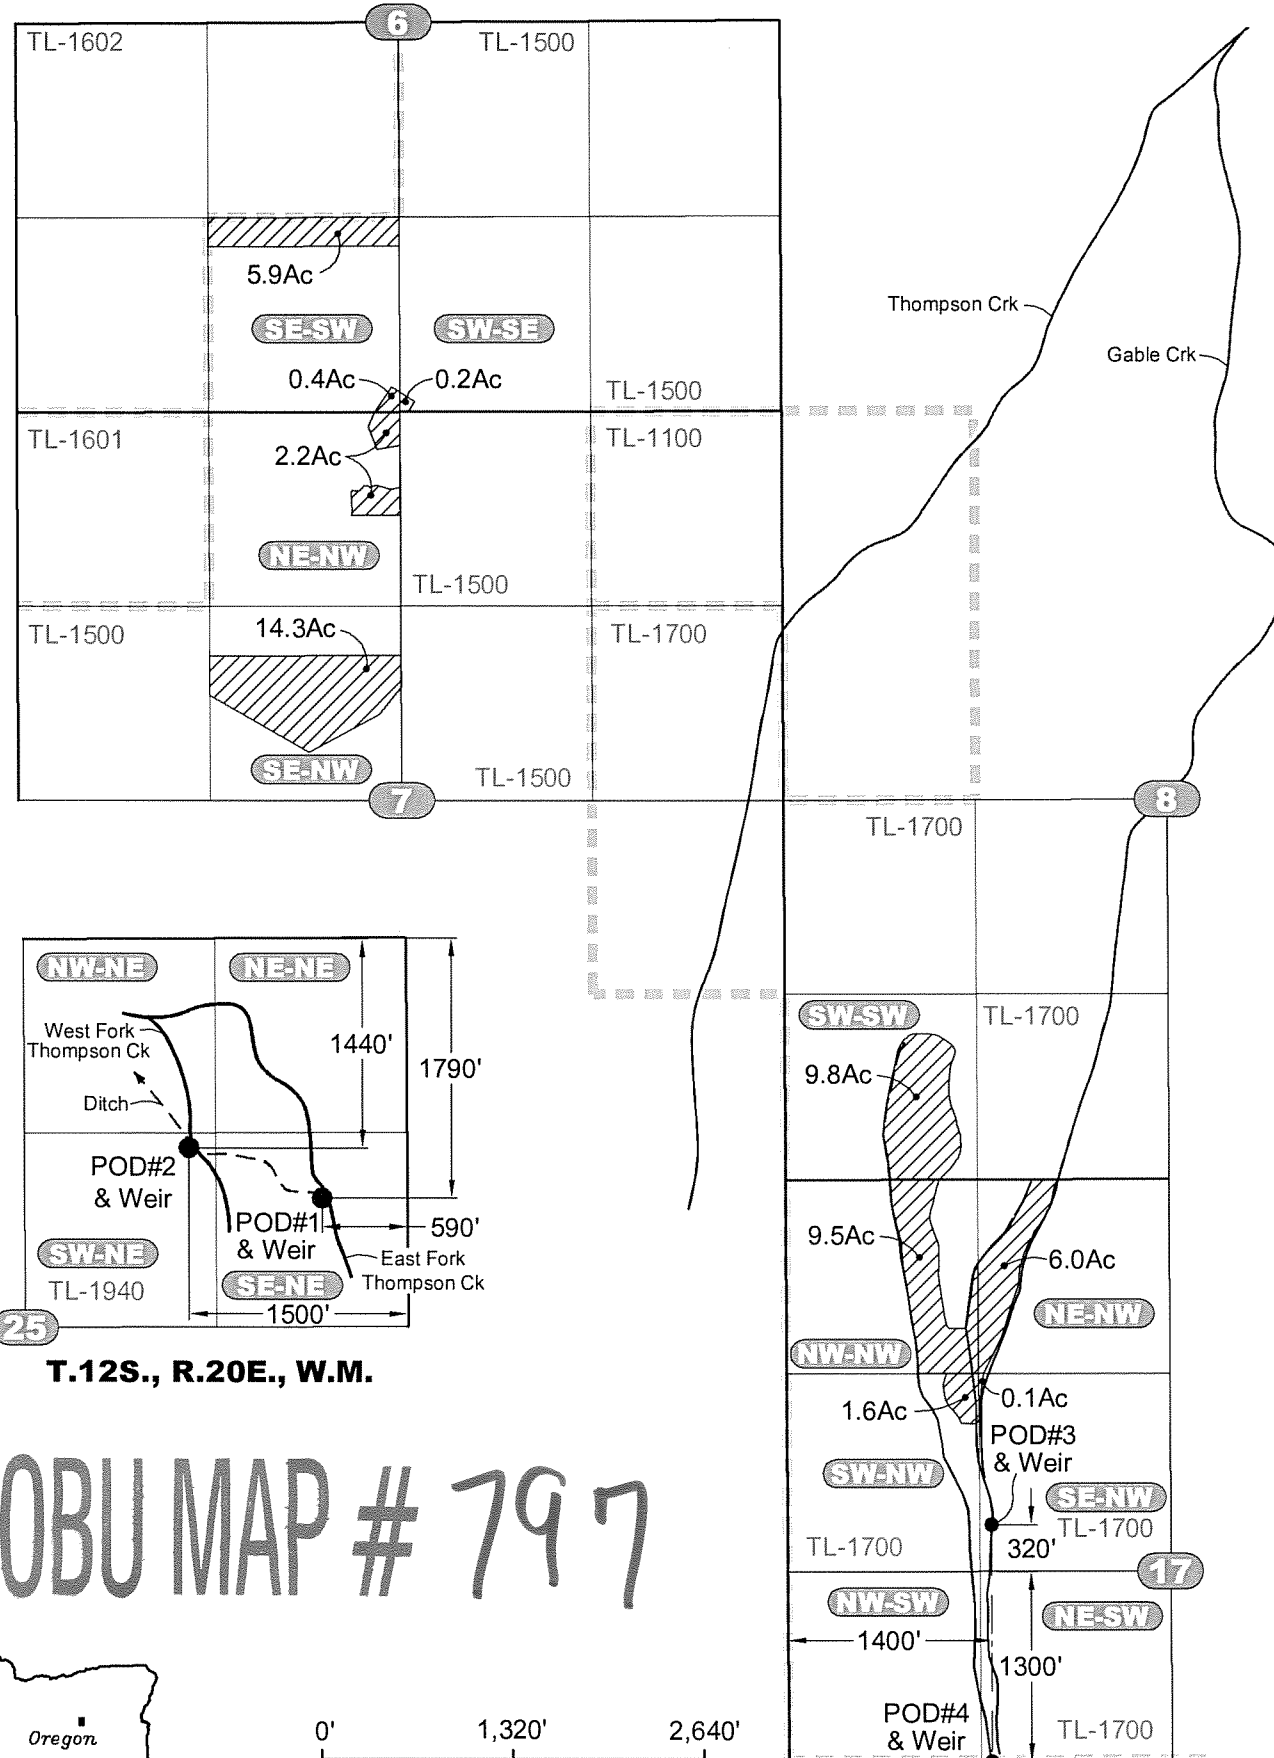


T.12S., R.20E., W.M.

COBU MAP # 797

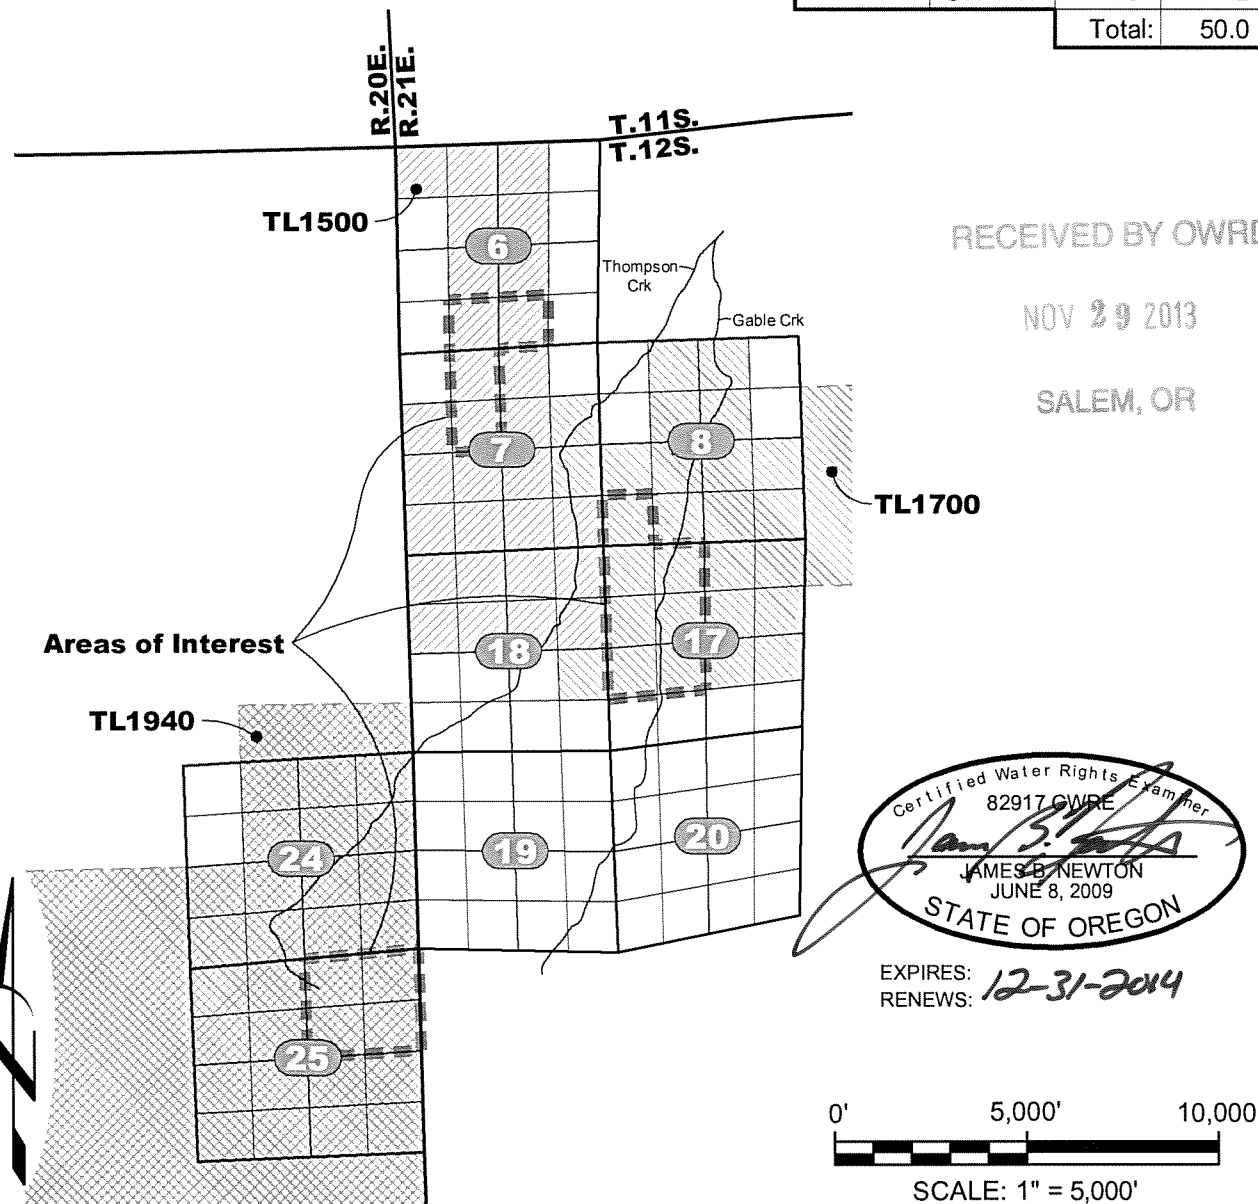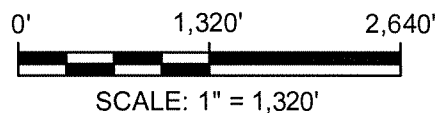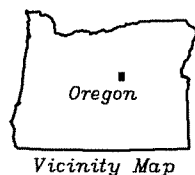


RECEIVED BY OWRD
NOV 29 2013
SALEM, OR

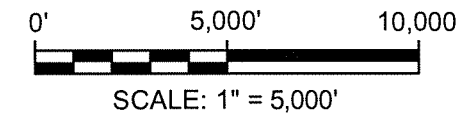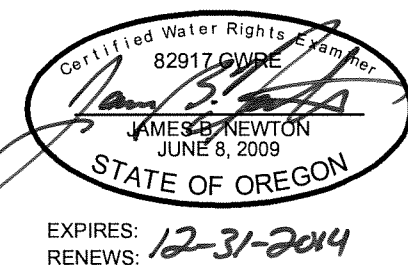

Final Proof Survey Map - Permit S-49188

White Butte Ranch
Wheeler County, Oregon

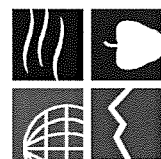

NEWTON
CONSULTANTS INC.
Earth, Water and Rock Specialists
Ph: 541 504-9980
Fax: 541 504-9981

DESIGNED BY: J. Newton

DRAWN BY: S. Schenck

DATE: NOV 2013

PROJECT NO. 1144-101

FIGURE 1