



FINAL PROOF SURVEY FOR T-9099
 in the name of
 BONANZA VIEW DAIRY PARTNERSHIP
 T 39 S R 11 E, W.M.

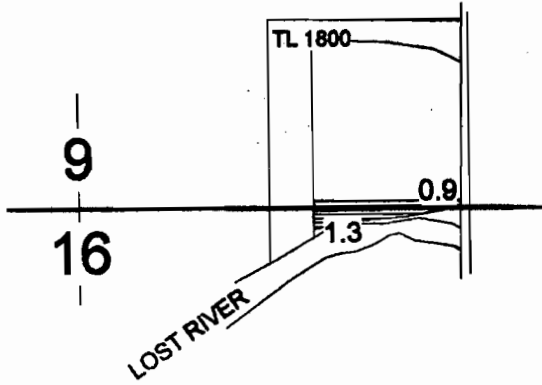

This map is for water
 right purpose only.

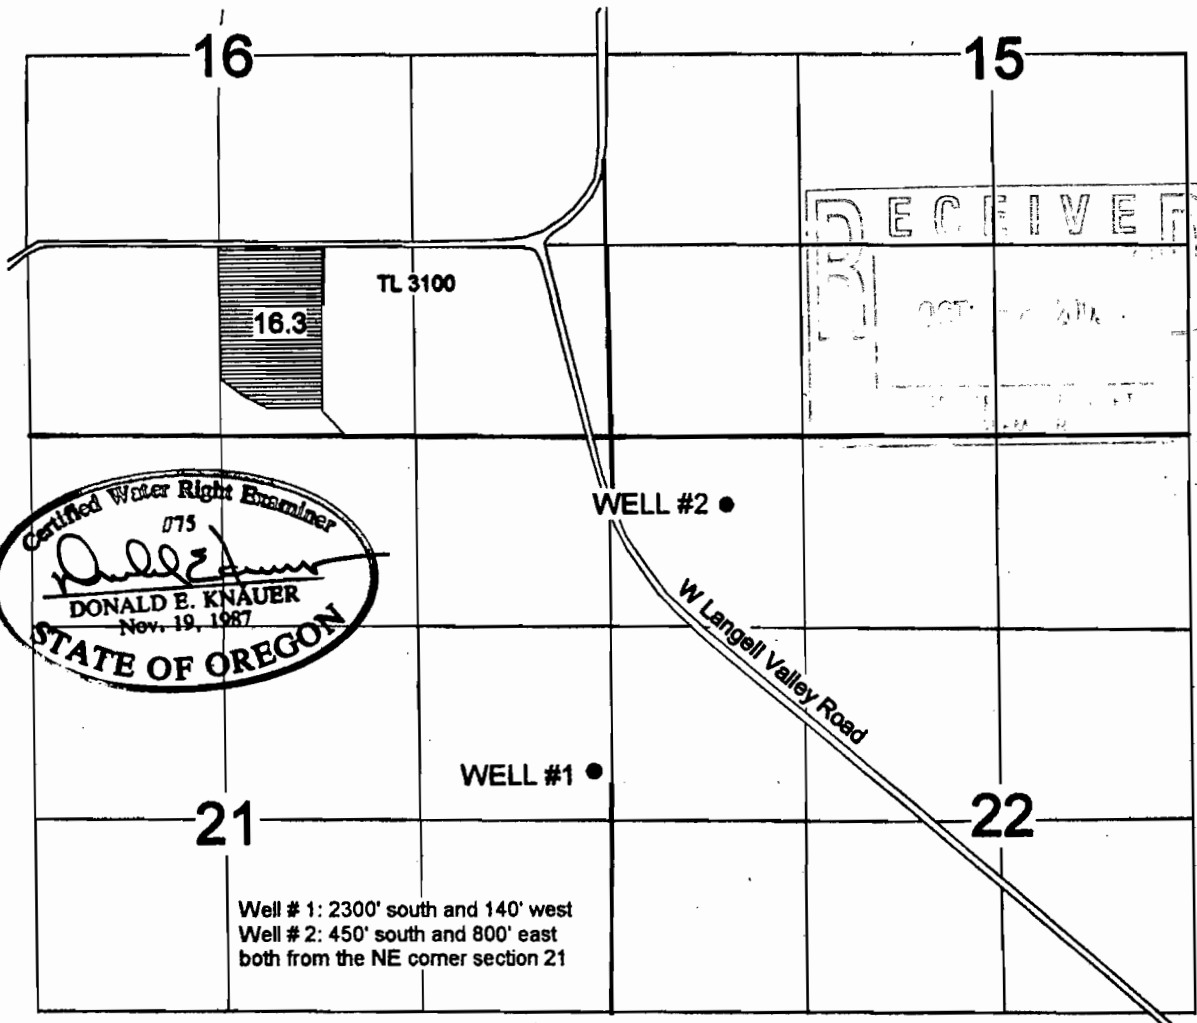

Certified Water Right Examiner
 075
Donald E. Knauer
 DONALD E. KNAUER
 Nov. 19, 1987
 STATE OF OREGON

Well # 1: 2300' south and 140' west
 Well # 2: 450' south and 800' east
 both from the NE corner section 21

4" = 1 mile

