


TOWNSHIPS 6 & 7 SOUTH, RANGE 21 EAST, W.M.

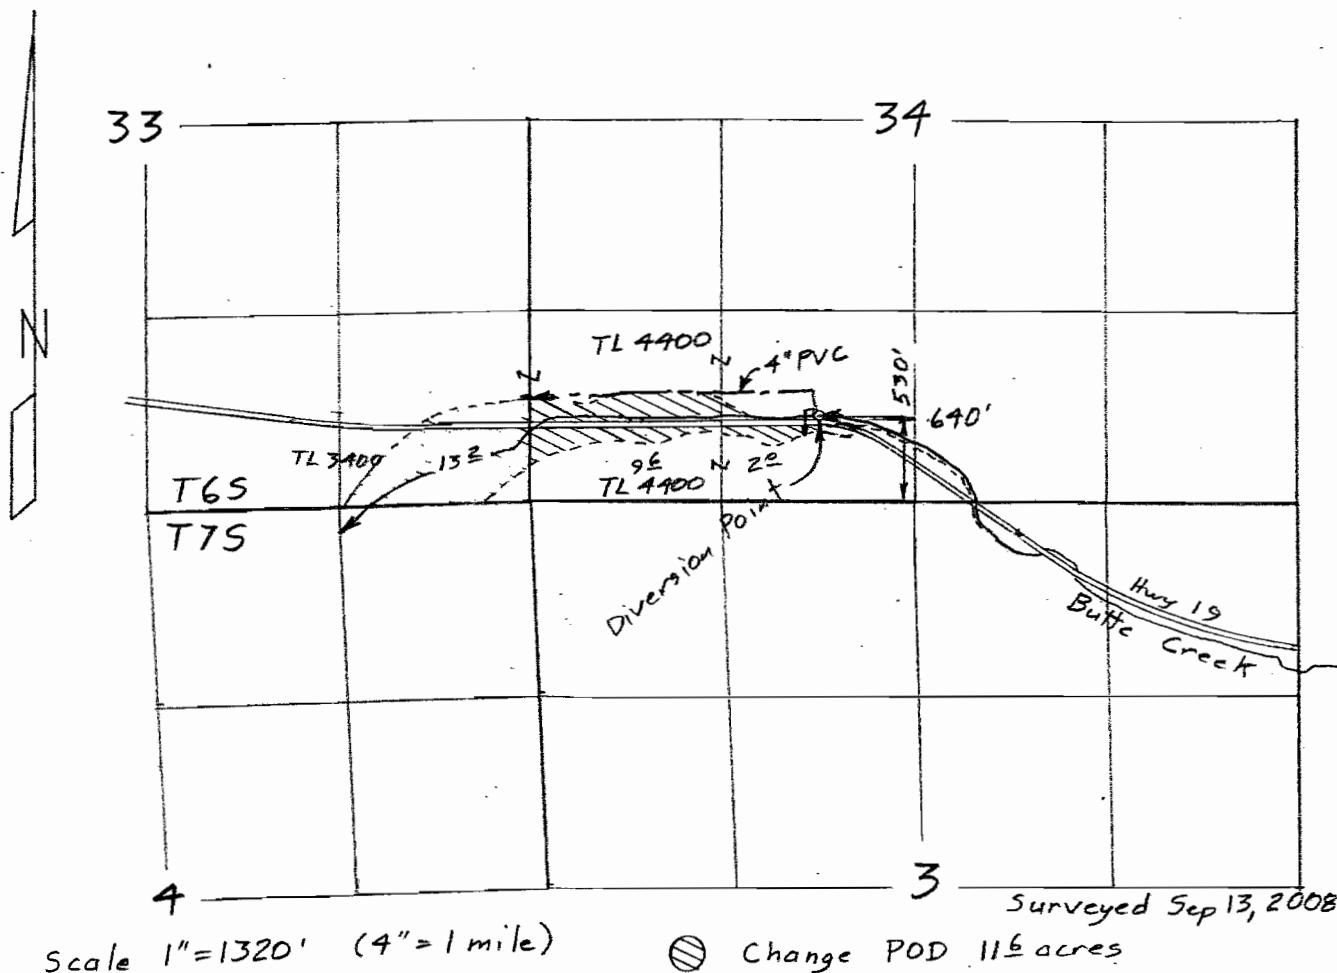

Scale 1"=1320' (4"=1 mile)

⊗ Change POD 116 acres

Surveyed Sep 13, 2008


Claim of Beneficial Use Map
for
DAN STUBBLEFIELD

T- 9882

RECEIVED

JAN 22 2009

WATER RESOURCES DEPT
SALEM, OREGON

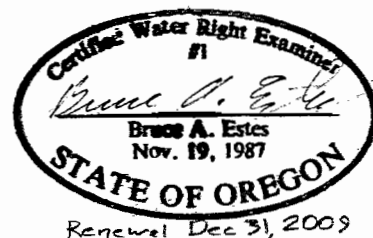

This map is for the purpose of
locating a water right only
and has no intent to provide
legal dimensions or the location
of property lines.

ESTES SURVEYS, LLC

PO Box 17519 60382 Arnold Rd
Salem, OR 97306-7519 Bend, OR 97702
(503) 585-7593 (541) 382-7391