


0538

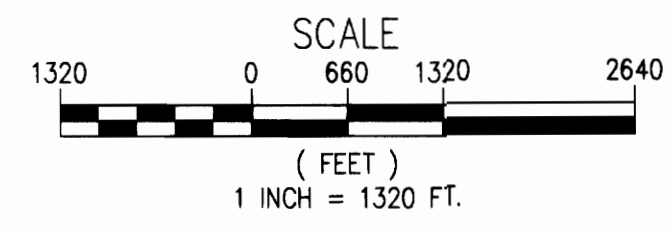

UNITED STATES FOREST SERVICE C/O MT. BACHELOR INC.  
CLAIM OF BENEFICIAL USE MAP  
APPLICATION G-13943, PERMIT G-12885  
SEPTEMBER, 2010  
LOCATED WITHIN TOWNSHIP 18 SOUTH, RANGE 9 EAST, W.M.,  
TOWNSHIP 18 SOUTH, RANGE 8 EAST, W.M.,  
TOWNSHIP 19 SOUTH, RANGE 9 EAST, W.M.

**LEGEND**

- EXISTING WELL LOCATION
- SECTION LINE
- QUARTER SECTION LINE
- SIXTEENTH SECTION LINE
- AREA OF USE FOR QUASI-MUNICIPAL WATER RIGHT (PERMIT G-12885)

POINT OF APPROPRIATION (MTB-02):  
TOWNSHIP 18 SOUTH, RANGE 9 EAST, W.M., SECTION 20,  
SE 1/4, NW 1/4.  
LOCATION: 1447' SOUTH AND 2256' EAST FROM THE  
NORTHWEST CORNER OF SECTION 20.

COBU MAP #0538



NOTE: THIS MAP WAS PREPARED FOR THE PURPOSE  
OF IDENTIFYING THE LOCATION OF WATER RIGHTS.  
THIS MAP IS NOT INTENDED TO PROVIDE LEGAL DIMENSIONS  
OR LOCATIONS OF PROPERTY OWNERSHIP LINES.

NOTE: THE LOCATIONS OF FEATURES SHOWN ON THIS MAP  
WERE OBTAINED FROM WHPACIFIC AS-BUILT CONSTRUCTION  
DRAWINGS, WHPACIFIC SURVEY TOPOGRAPHIC DATA,  
DESCHUTES COUNTY GIS, FIELD MAPPING USING A  
GEOEXPLORER MODEL NUMBER 79000-00 HAND HELD GPS  
RECEIVER, AERIAL AUTOCAD INFORMATION AND FROM  
INTERVIEWING MT. BACHELOR INC. STAFF.

**WHPacific**

123 SW Columbia Street  
Bend, OR 97702  
541-388-4255 Fax 541-388-4229  
www.whpacific.com

