

# CLAIM OF BENEFICIAL USE MAP

TRANSFER: T-9031


FOR  
WARREN C. AND JESSE E. LAIRD

LOCATED IN SECTION 4  
TOWNSHIP 36 SOUTH, RANGE 24 EAST, W.M.,  
LAKE COUNTY, OREGON



SCALE 1"=1320'

EXISTING WELL, LOCATED IN THE  
WARNER LAKE BASIN;  
P.O.A. LOCATED SOUTH 11 FEET  
AND EAST 13 FEET FROM THE  
NORTH 1/4 CORNER OF SECTION 4.

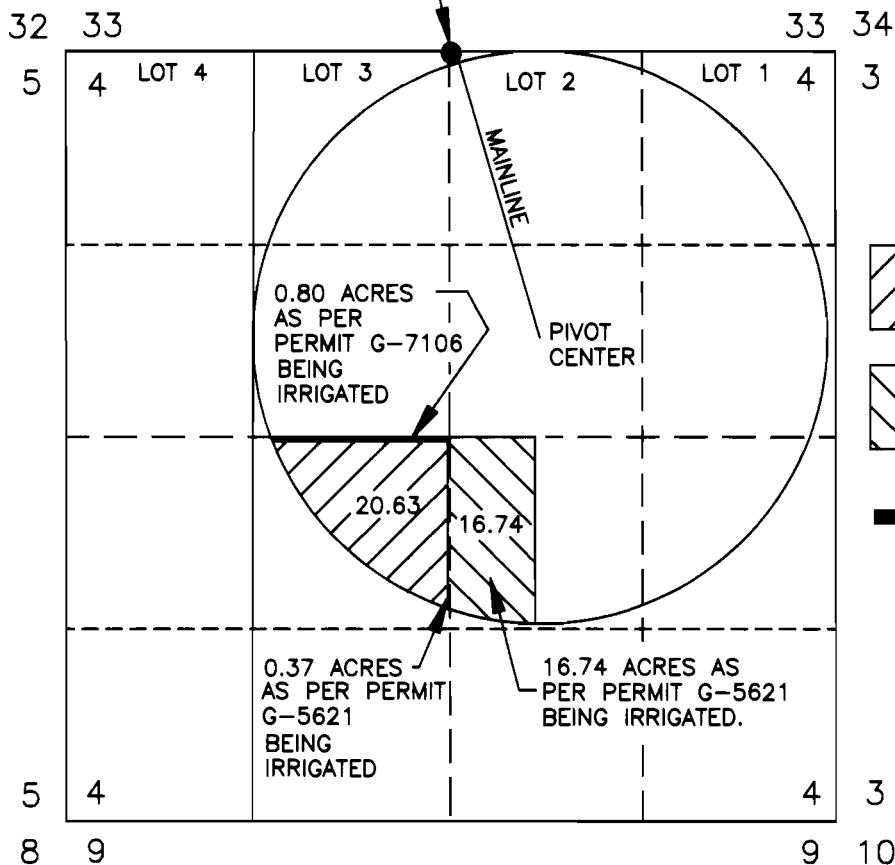

## LEGEND



20.63 ACRES AS PER  
PERMIT G-584 BEING  
IRRIGATED, AS SHOWN.



17.11 ACRES AS PER  
PERMIT G-5621 BEING  
IRRIGATED, AS SHOWN.




0.8 ACRES AS PER  
PERMIT G-7106 BEING  
IRRIGATED, AS SHOWN.

**RECEIVED**

NOV 24 2003

WATER RESOURCES DEPT  
SALEM OREGON

THIS MAP IS FOR THE PURPOSE OF LOCATING A  
WATER RIGHT ONLY AND HAS NO INTENT TO PROVIDE  
LEGAL DIMENSIONS OR THE LOCATION OF  
PROPERTY LINES.

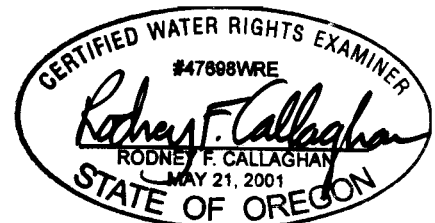

RE-NEW: 12/31/03

PREPARED FOR: WARREN C. AND JESSE E. LAIRD  
P.O. BOX 13  
PLUSH, OR 97637

PREPARED BY:

**CLS**

CALLAGHAN LAND SURVEYING  
427 SOUTH H STREET  
LAKEVIEW, OR 97630  
(541) 947-5841

DATE: 9/27/03

DRAWING: 200358