

CLAIM OF BENEFICIAL USE MAP

TRANSFER: T-9031


FOR
WARREN C. AND JESSE E. LAIRD

LOCATED IN SECTION 4
TOWNSHIP 36 SOUTH, RANGE 24 EAST, W.M.,
LAKE COUNTY, OREGON



SCALE 1"=1320'

EXISTING WELL, LOCATED IN THE
WARNER LAKE BASIN;
P.O.A. LOCATED SOUTH 11 FEET
AND EAST 13 FEET FROM THE
NORTH 1/4 CORNER OF SECTION 4.

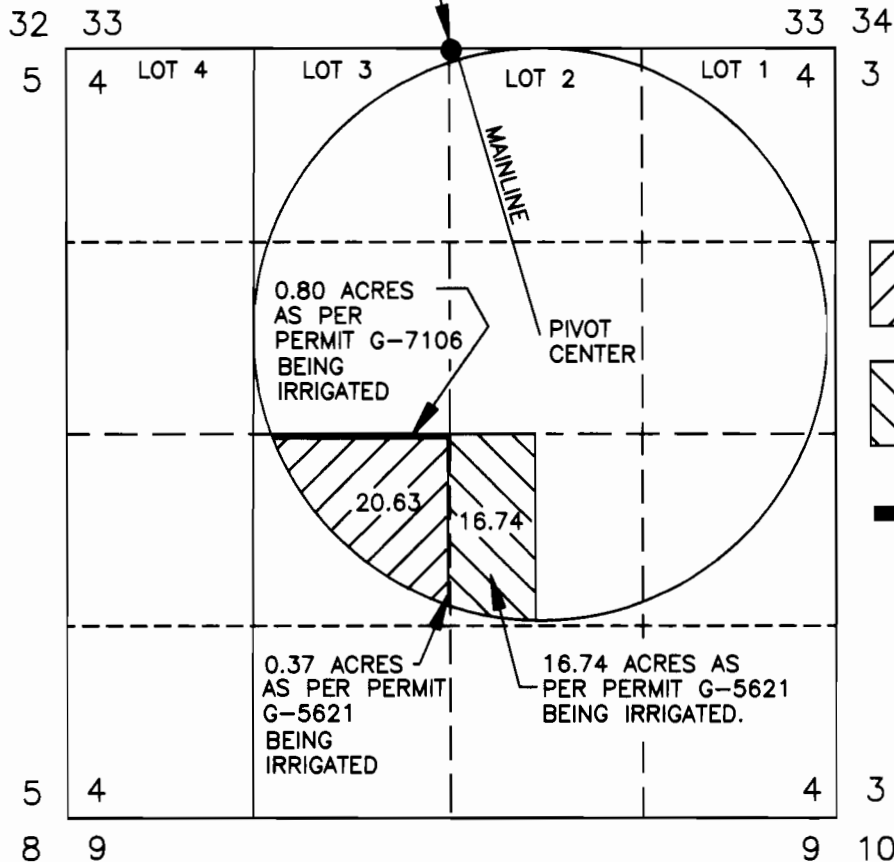

LEGEND



20.63 ACRES AS PER
PERMIT G-584 BEING
IRRIGATED, AS SHOWN.



17.11 ACRES AS PER
PERMIT G-5621 BEING
IRRIGATED, AS SHOWN.




0.8 ACRES AS PER
PERMIT G-7106 BEING
IRRIGATED, AS SHOWN.

RECEIVED

NOV 24 2003

WATER RESOURCES DEPT
SALEM OREGON

THIS MAP IS FOR THE PURPOSE OF LOCATING A
WATER RIGHT ONLY AND HAS NO INTENT TO PROVIDE
LEGAL DIMENSIONS OR THE LOCATION OF
PROPERTY LINES.

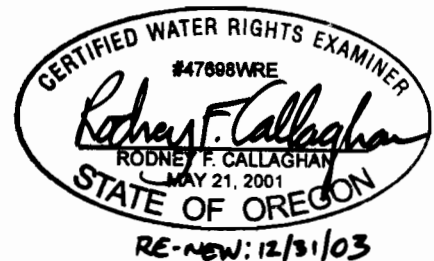

PREPARED FOR: WARREN C. AND JESSE E. LAIRD
P.O. BOX 13
PLUSH, OR 97637

PREPARED BY:
CALLAGHAN LAND SURVEYING
427 SOUTH H STREET
LAKEVIEW, OR 97630
(541) 947-5841

DATE: 9/27/03

DRAWING: 200358