



*Completed*  
**Proposed Reservoir**  
**35-4W-33-300**

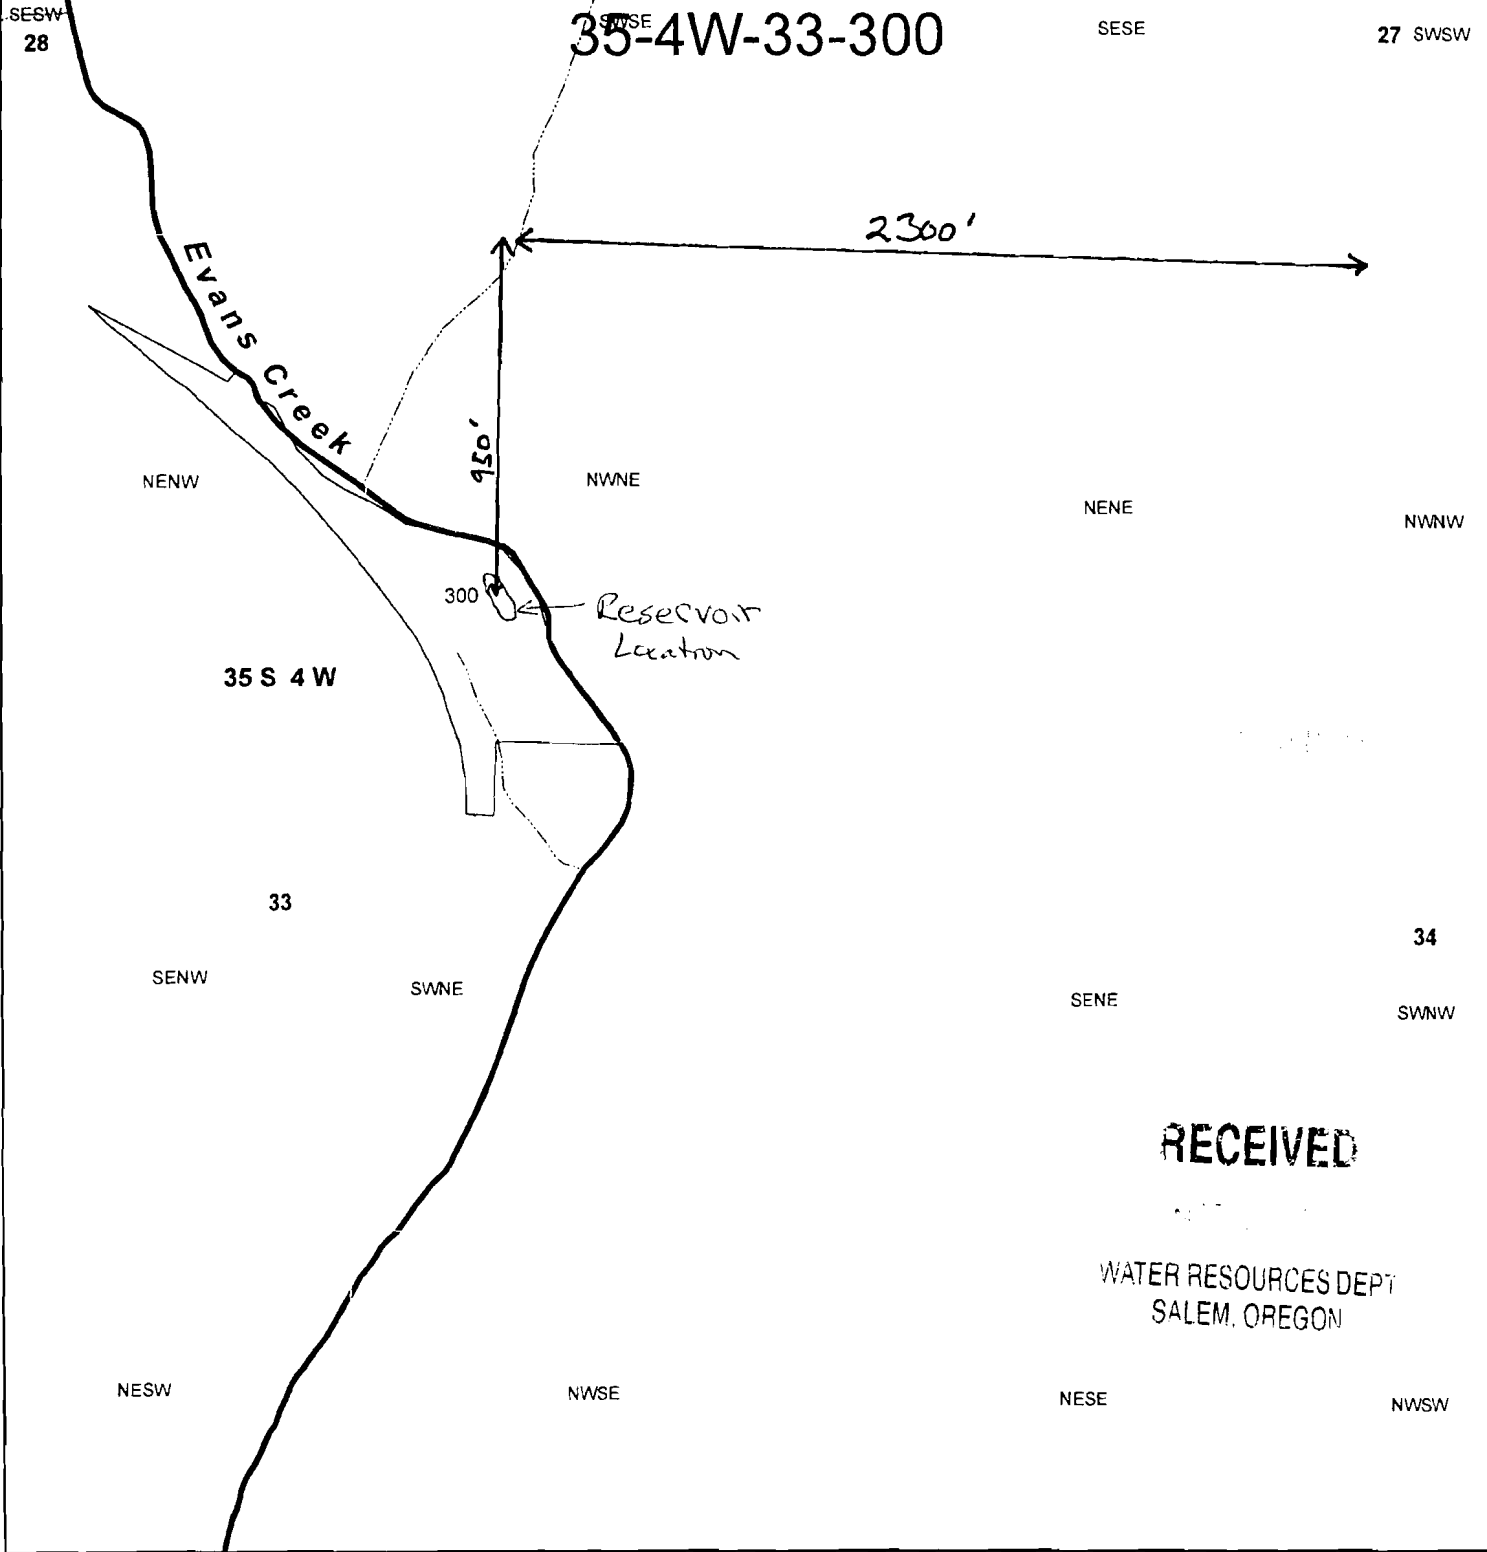

**RECEIVED**

WATER RESOURCES DEPT  
SALEM, OREGON

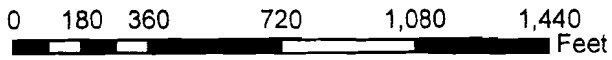

1 inch = 500 feet

R-87740

**Legend**

Tax Lot

Townships

Sections

Quarter quarters