


Alternate Review Reservoir
Application Map
for
John Stiner
T. 13S R. 30E W.M. Sec. 18

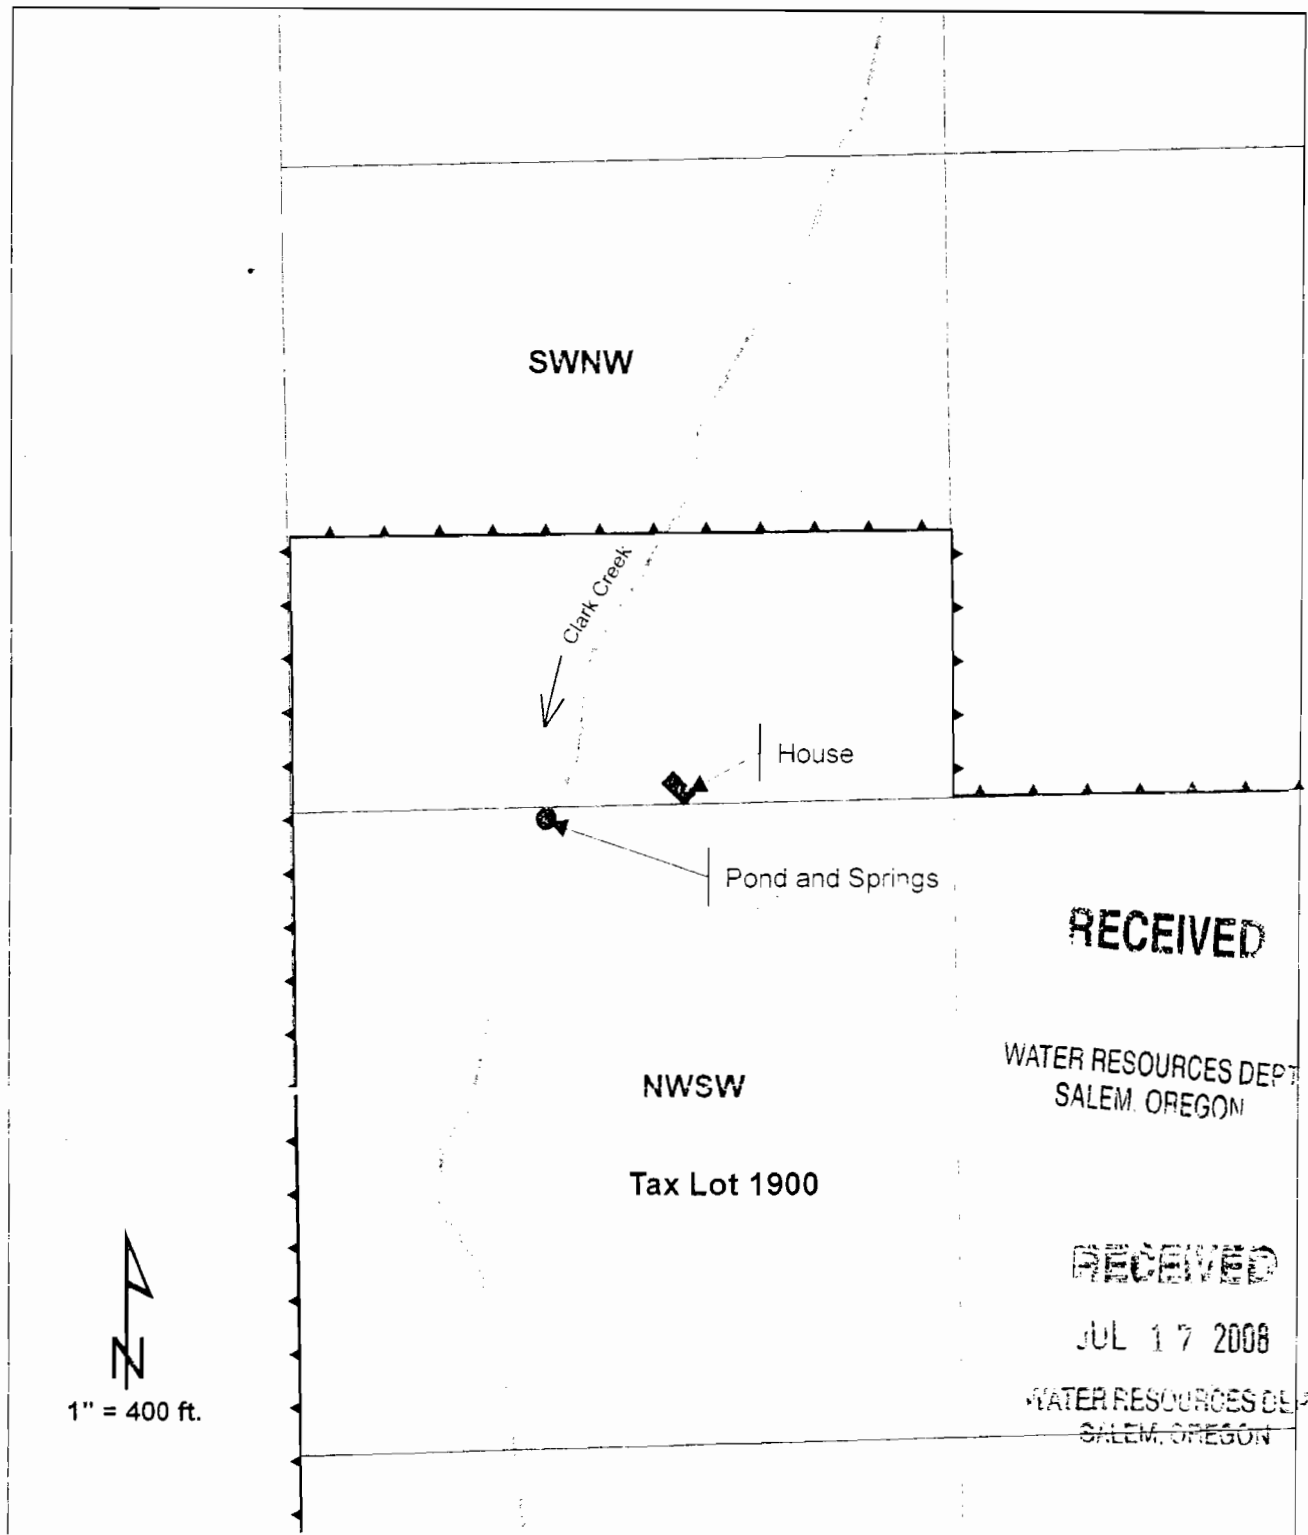

Pond is located 2640 ft north and 520 feet east from the south west corner of section 18 being within the NW 1/4 of the SW 1/4 Section 18 of T. 13S R. 30E W.M.

Note: The springs that contribute to the filling of the pond are located immediately above the pond within a few feet.

The springs are visible during low flow periods, they are located on the east side of the Clark Creek channel.

App No R87233

E. Julsrud, 07/14/2008