


Claim of Beneficial Use Map for SHOTGUN RANCH, LLC

Pond #2
App R-86752
Per R-14419

Pond #3
App R-86754
Per R-14421


Pond #5
App R-86756
Per R-14423

T. 17S., R. 20 E., W. 11.

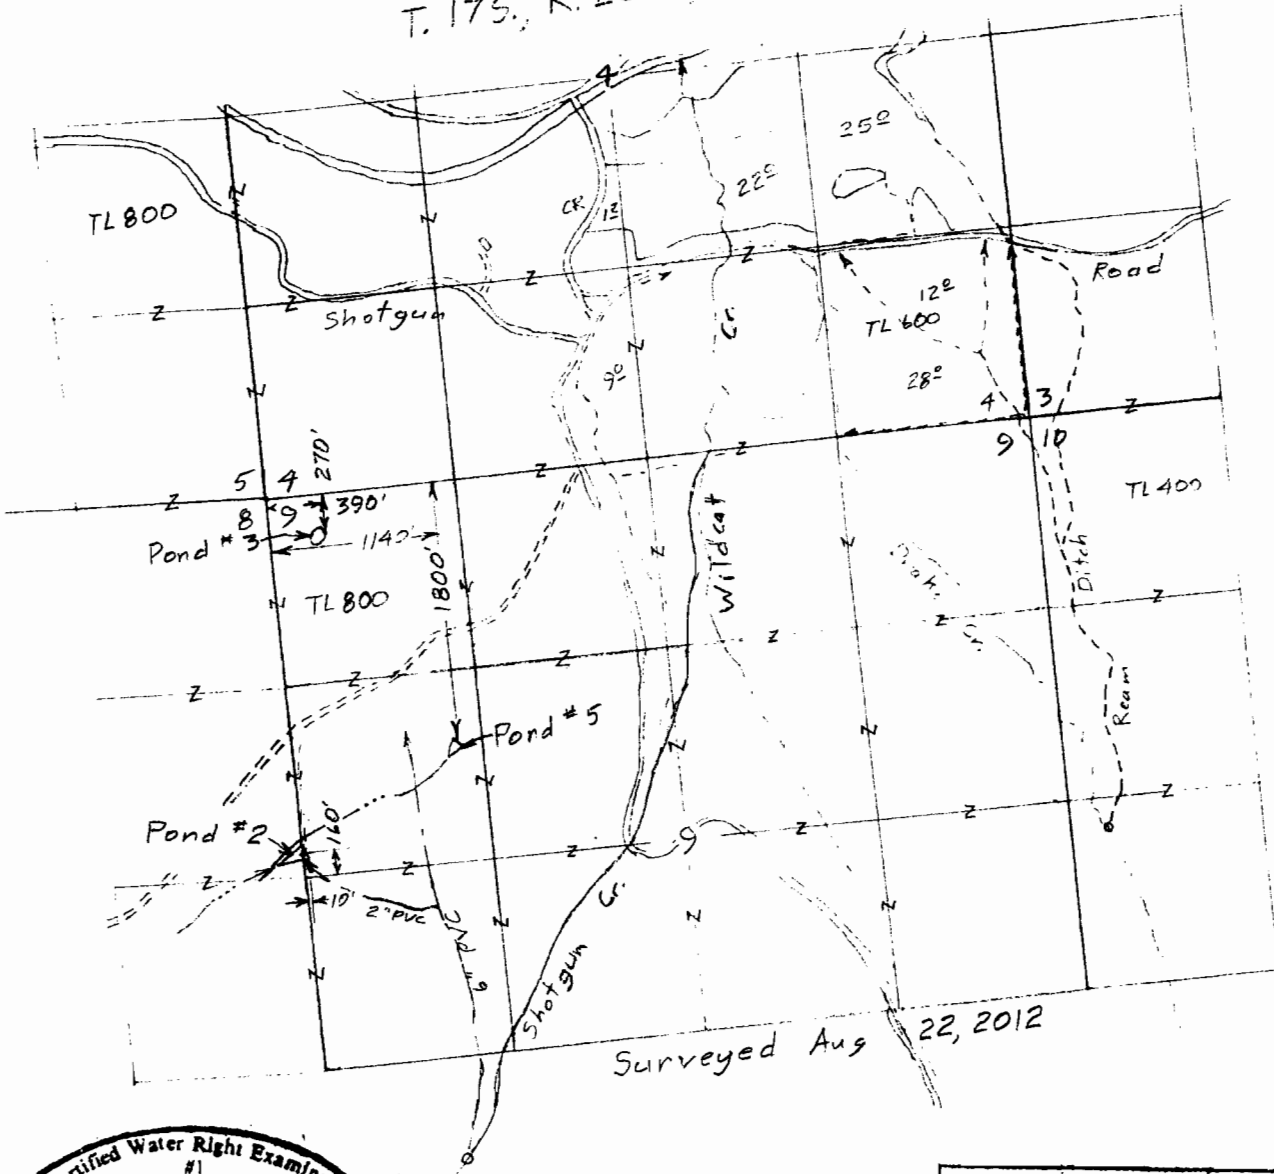

Scale 1" = 1320'
(4" = 1 mile)

Surveyed Aug 22, 2012

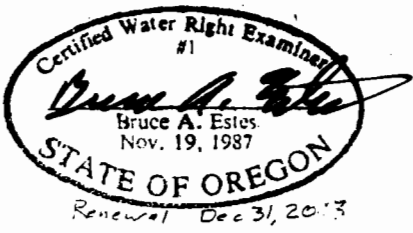

This map is for the purpose of locating a water right only and has no intent to provide legal dimensions or the location of property lines.

ESTES SURVEYS, LLC

<p>PO Box 17519 Salem, OR 97905-7519 (503) 305-7599</p>	<p>60382 Arnold Rd Bend, OR 97702 (541) 382-7391</p>
---	--