



T. 17 S., R. 20 E., W. M.

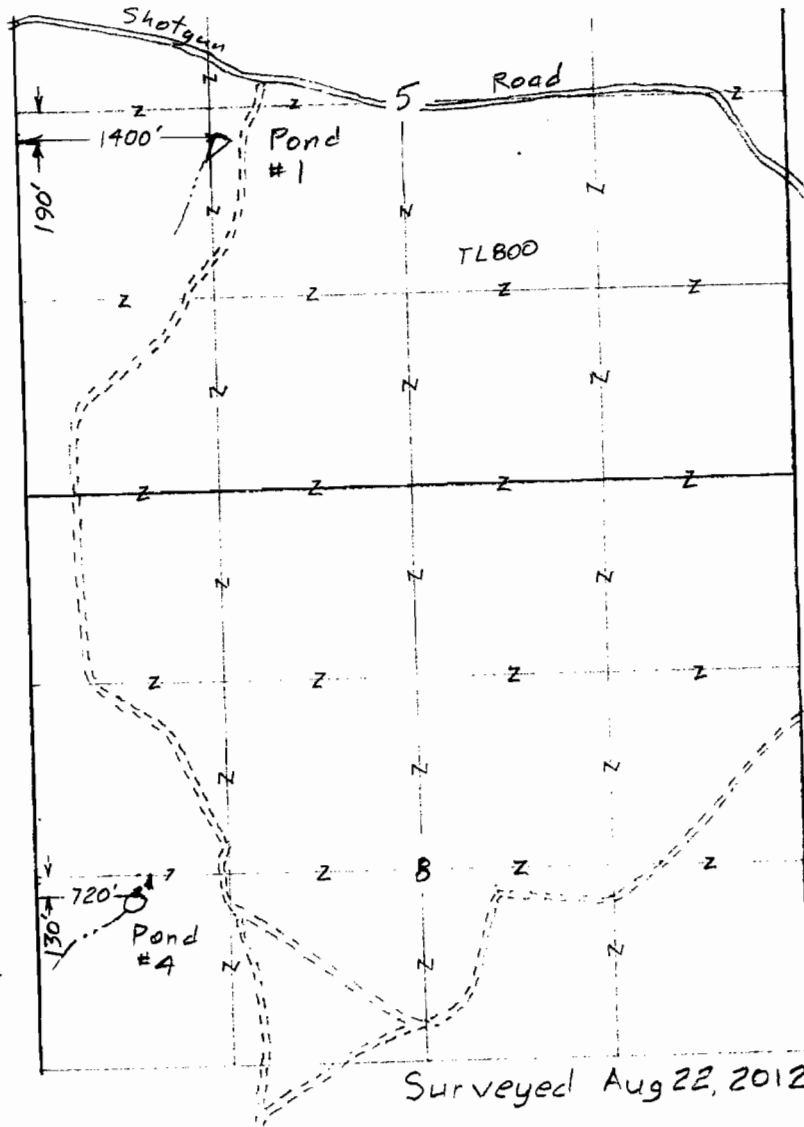

Scale 1" = 1320'
(4" = 1 mile)

Ponds #1 & #4
#1 App R-86753
Per R-14420
#4 App R-86755
Per R-14422

Claim of Beneficial Use Map for SHOTGUN RANCH, LLC

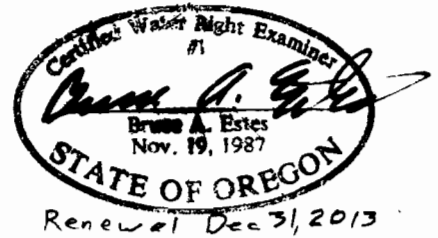

This map is for the purpose of locating a water right only and has no intent to provide legal dimensions or the location of property lines.

ESTES SURVEYS, LLC
PO Box 17510
Salem, OR 97306-7510
(503) 505-7505
60382 Arnold Rd
Bend, OR 97702
(541) 382-7391