

Don Nutting

Dam Location:

1000' S. and 1160' W.

of E. 1/4 Cor., T. 2S., R. 5 E.,

Section 32

Reservoir Location:

NE 1/4, SE 1/4,

T. 2 S., R. 5 E., Sec. 32

Tax Lot 900


Scale: 1" = 400'

app # B 86186
Permit no 12 14178

RECEIVED

SEP 16 2009

WATER RESOURCES DEPT
SALEM, OREGON

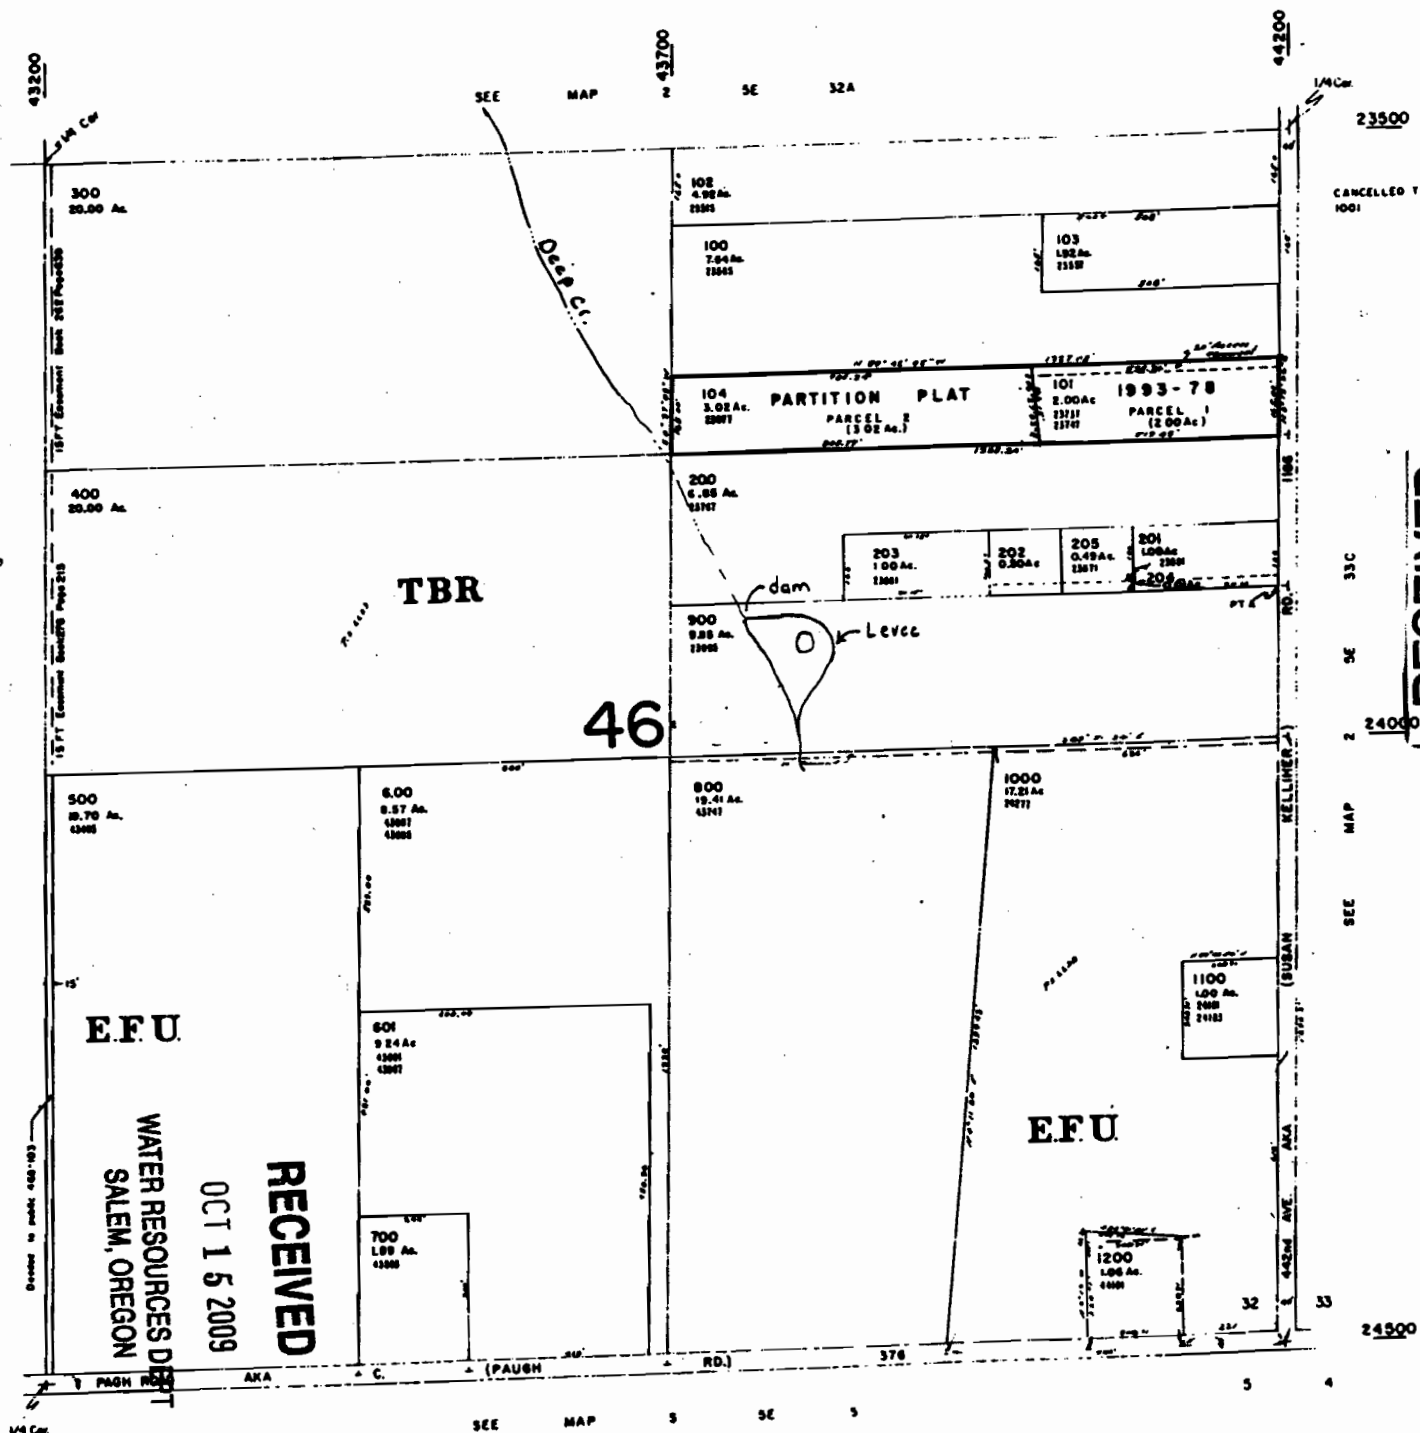

23500

CANCELLED TL'S
1001

RECEIVED

MAR 02 2005

**WATER RESOURCES DEPT
SALEM, OREGON**

SEE MAP 2 35 33C

2400

MAP

335

5

1

2 5E 32D