



Portland\p:\9568001\00\CAD\Fig_1A.dwg SRB:MWJ 11/08/04

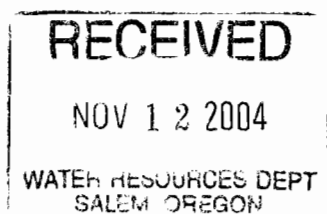

**T3S, R2E SECTION 30
CLACKAMAS COUNTY**
APPLICATION R-85067, PERMIT R-13488

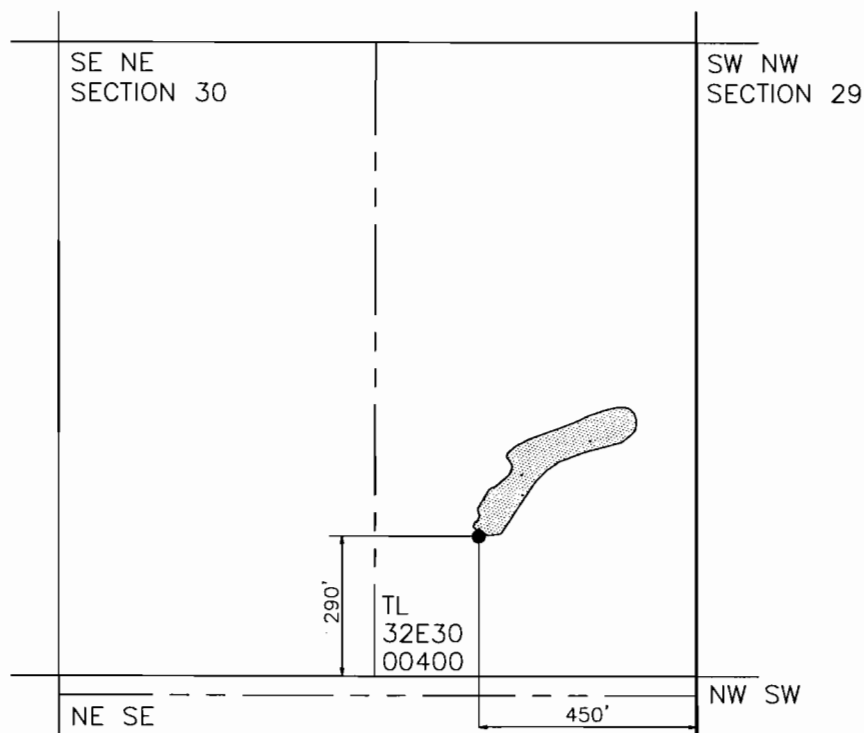

EXPLANATION:



RESERVOIR



POINT OF DIVERSION



APPROXIMATE PROPERTY LINE

THE PURPOSE OF THIS MAP IS TO IDENTIFY THE
LOCATION OF THE PROPOSED WATER RIGHT. IT IS NOT
INTENDED TO PROVIDE INFORMATION RELATIVE TO THE
LOCATION OF PROPERTY OWNERSHIP BOUNDARY LINES.

GEOENGINEERS

**CLAIM OF BENEFICIAL USE MAP
WILLIAM BLACKLAW**

FIGURE 1