BMT, LLC
R87673

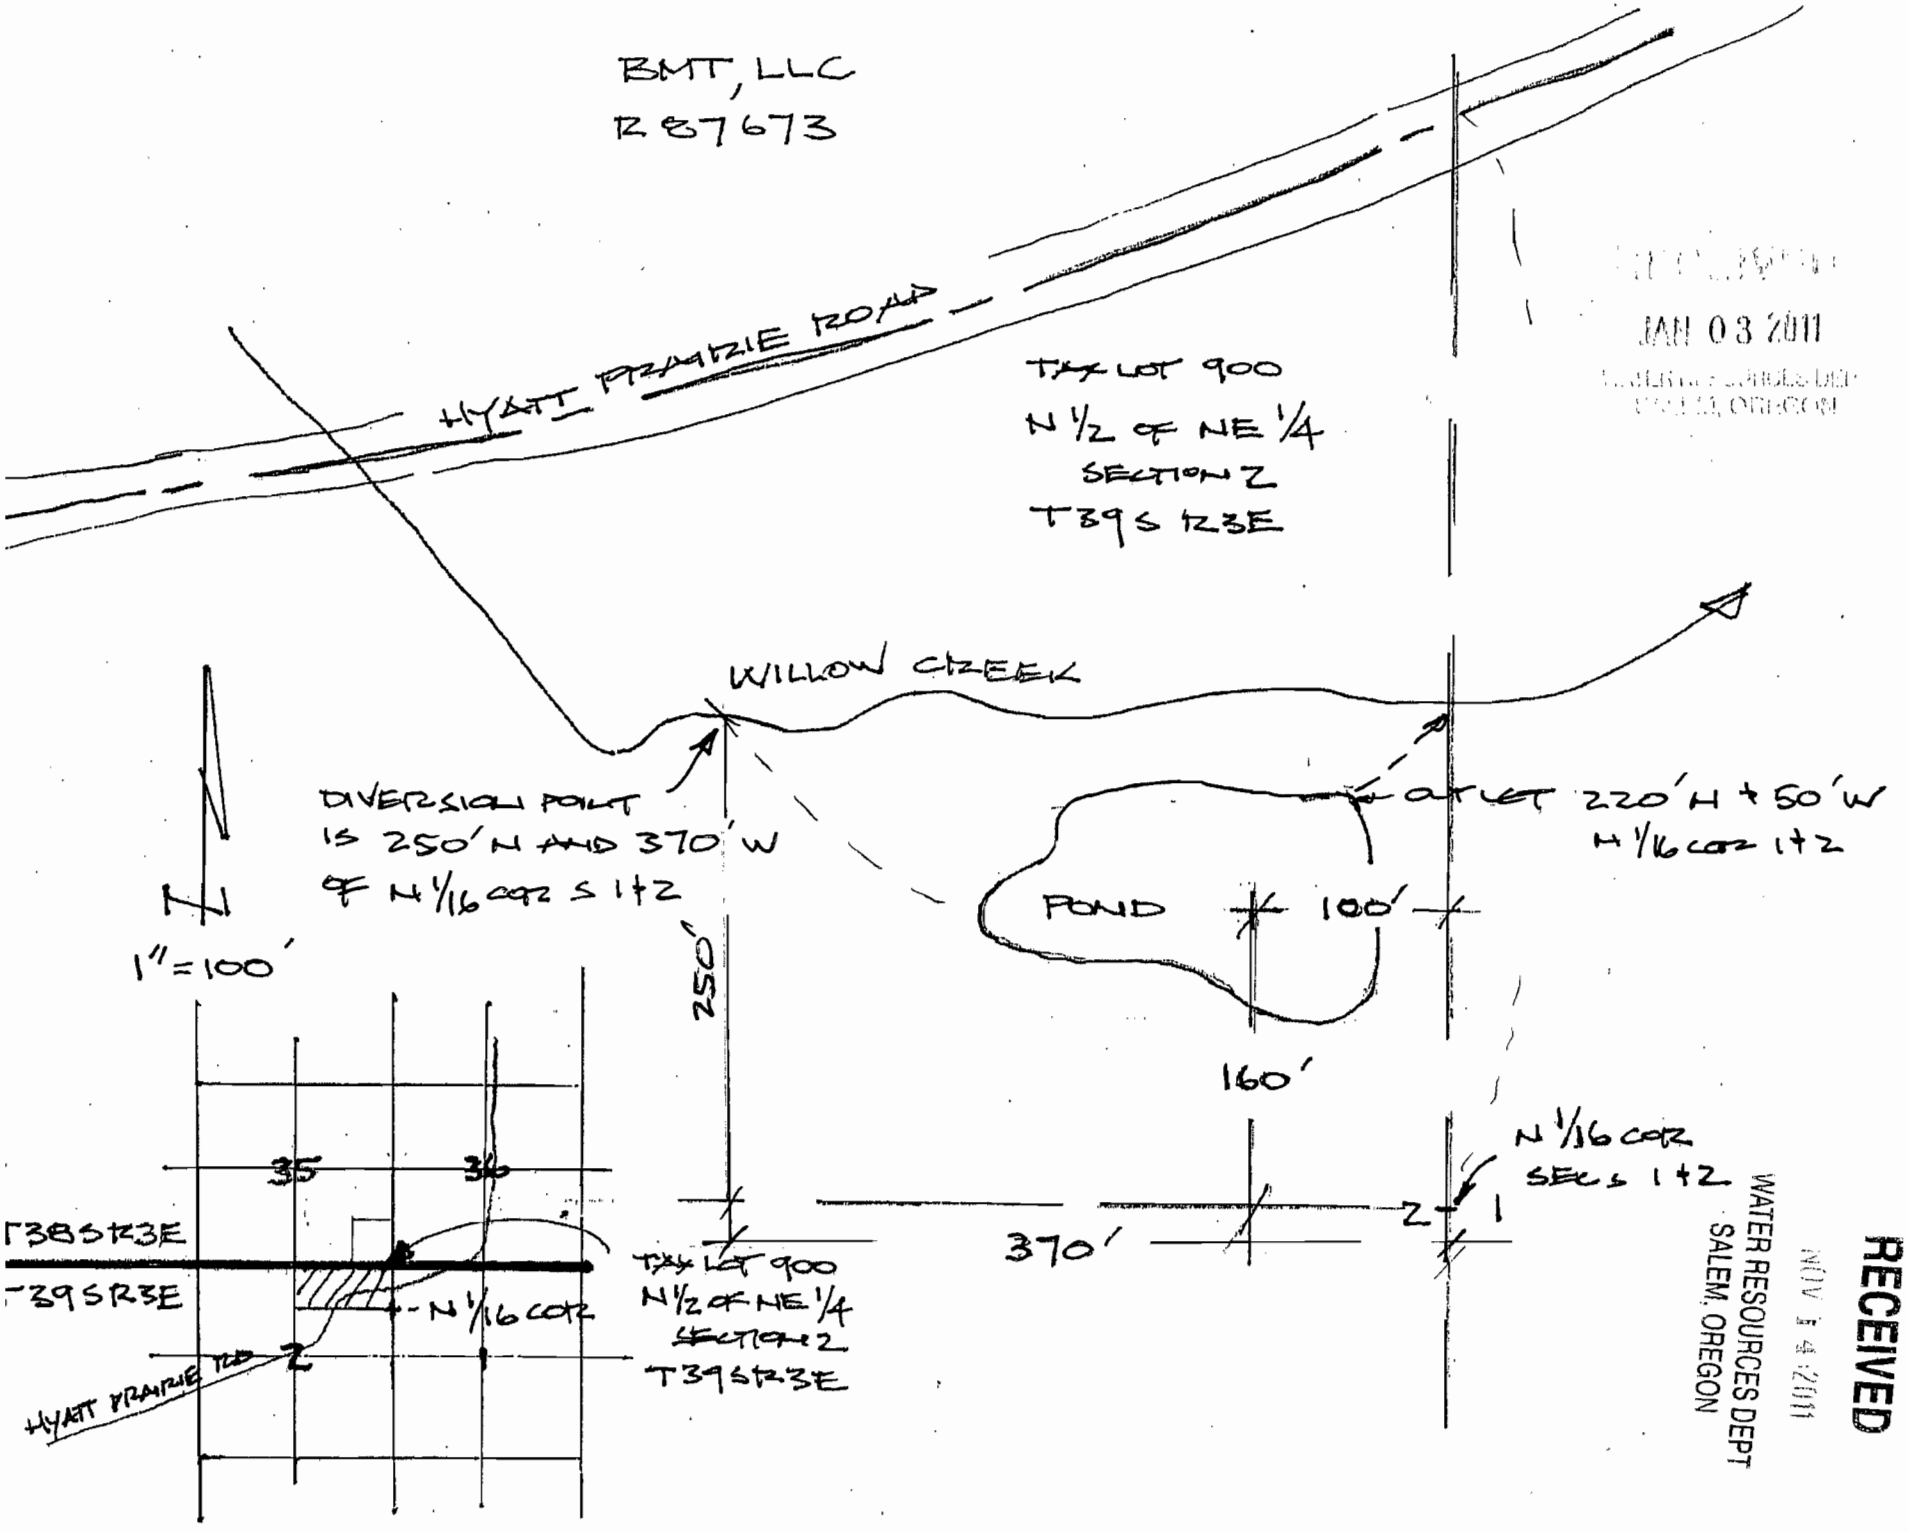

JAN 03 2011
WATER RESOURCES DEPT
SALEM, OREGON

RECEIVED
NOV 1 4 2011
WATER RESOURCES DEPT
SALEM, OREGON