


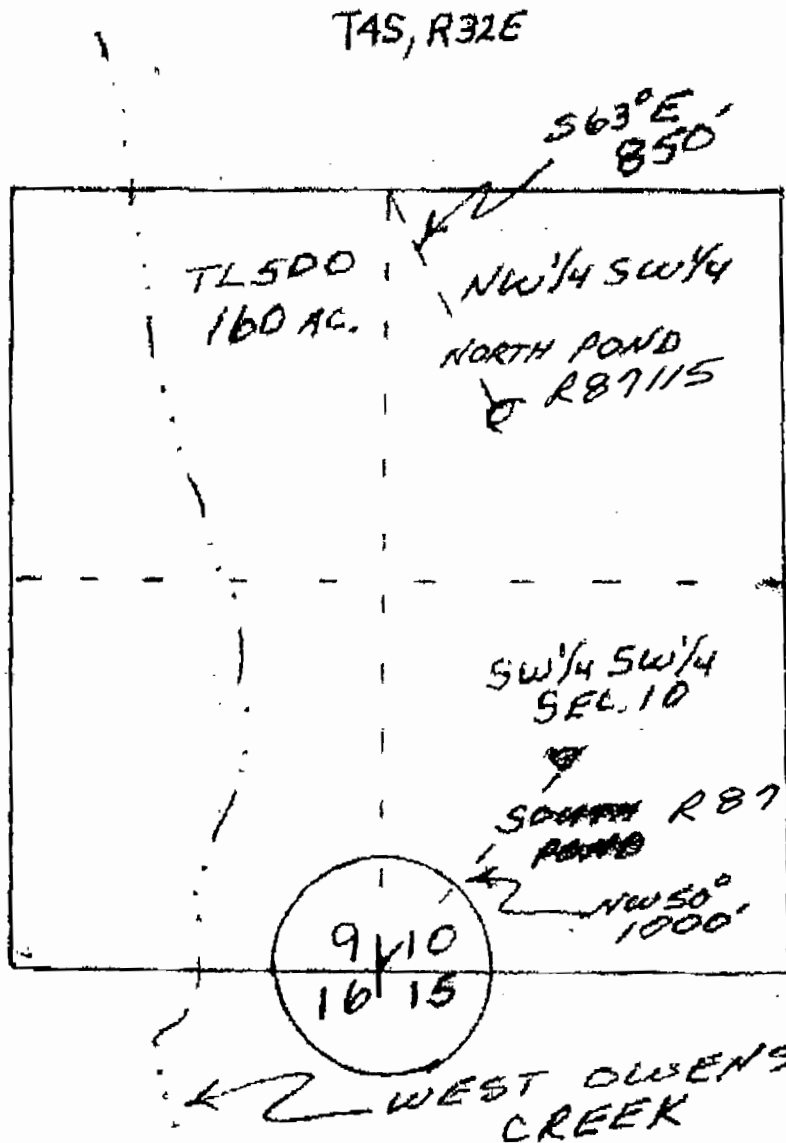

RECEIVED

OCT 21 2009

WATER RESOURCES DEPT
SALEM, OREGON

RECEIVED

SEP 21 2009

WATER RESOURCES DEPT
SALEM, OREGON

BOTH RESERVOIR(S) LOCATED FROM
SW CORNER SECTION 10

NORTH POND
1900 FE NORTH
380 FE EAST

SOUTH POND
730 FE NORTH
620 FE EAST

REVISED CORRECTED
APPROX SCALE
1" = 600 FEET


RECEIVED

MAR 10 2008

WATER RESOURCES DEPT
SALEM, OREGON

0 1000 2000 Feet



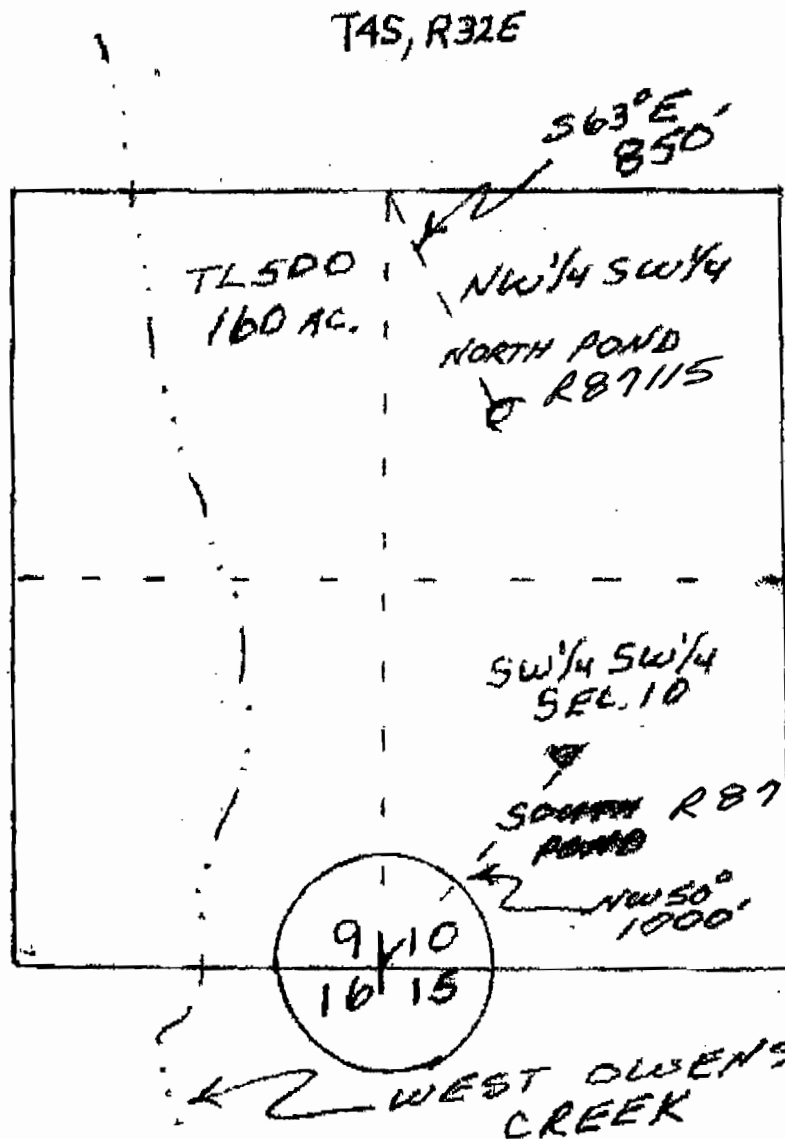

OWENS
CR.

RECEIVED

OCT 21 2009

WATER RESOURCES DEPT
SALEM, OREGON

RECEIVED

SEP 21 2009

WATER RESOURCES DEPT
SALEM, OREGON

BOTH RESERVOIR(S) LOCATED FROM
SW CORNER SECTION 10

NORTH POND
1900 FE NORTH
380 FE EAST
SOUTH POND
730 FE NORTH
620 FE EAST

REVISED CORRECTED
APPROX SCALE
1" = 600 FEET

RECEIVED

MAR 10 2008

WATER RESOURCES DEPT
SALEM, OREGON



0 1000 2000 Feet