


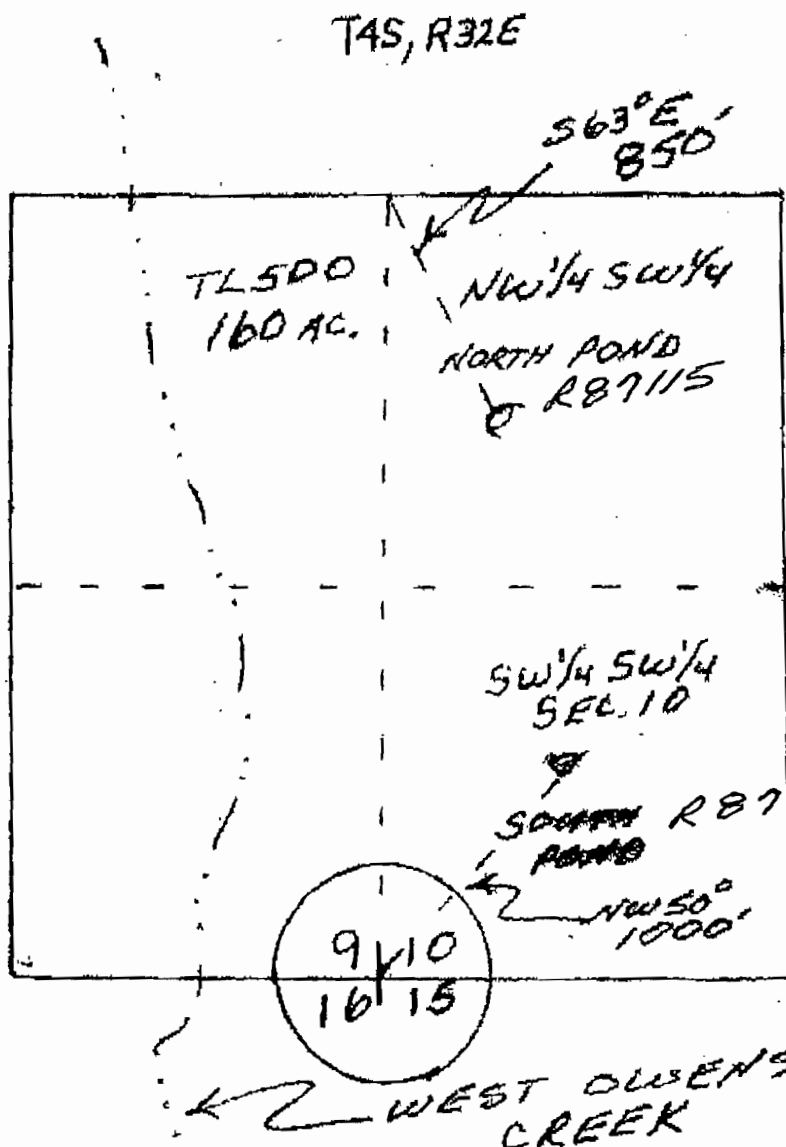

RECEIVED

OCT 21 2009

WATER RESOURCES DEPT  
SALEM, OREGON

RECEIVED

SEP 21 2009

WATER RESOURCES DEPT  
SALEM, OREGON

BOTH RESERVOIR(S) LOCATED FROM  
SW CORNER SECTION 10

NORTH POND  
1900 ft NORTH  
380 ft EAST

SOUTH POND  
730 ft NORTH  
620 ft EAST

REVISED COLLECTED  
APPROX SCALE  
1" = 600 FEET

RECEIVED

MAR 10 2008

WATER RESOURCES DEPT  
SALEM, OREGON



0 1000 2000 Feet