



**CLAIM OF BENEFICIAL USE MAP
FOR
ZENITH VINEYARD
TAX LOT 104 MAP T6S, R4W, W.M., SEC26
AUGUST 2, 2011**

EXHIBIT A
PERMIT # R-14120
APPLICATION # R-86123

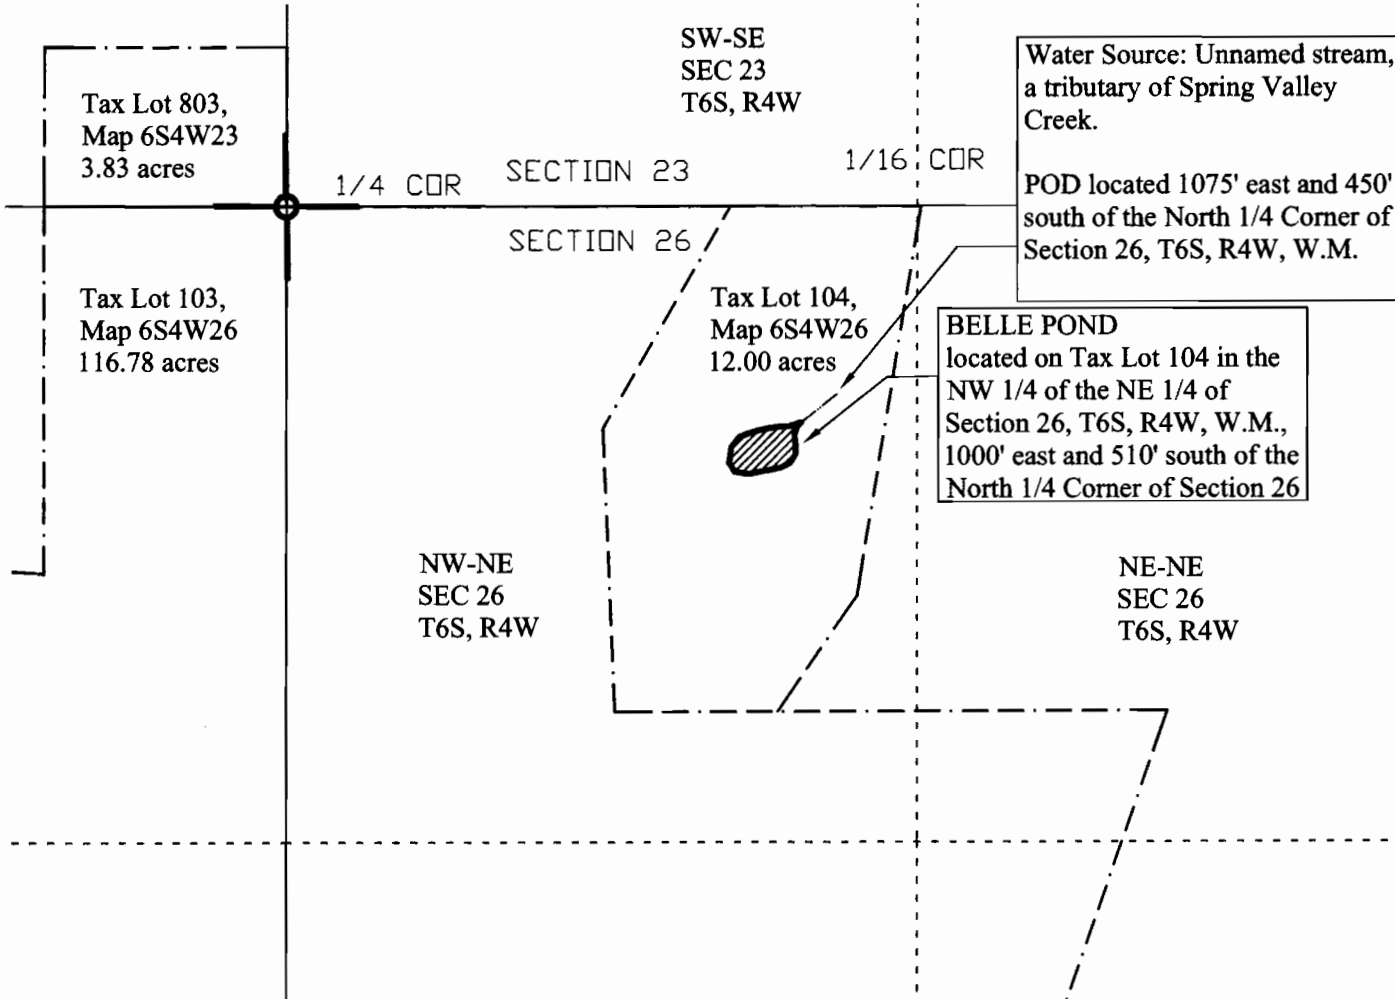


THIS MAP IS NOT INTENDED TO PROVIDE LEGAL DIMENSIONS OR LOCATION OF PROPERTY OWNERSHIP LINES.

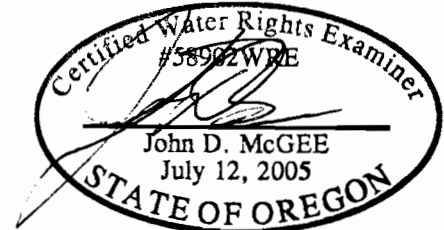

RENEWAL DATE: 12/31/2012

LEGEND

- QTR SECTION LINES
- QTR-QTR LINES
- /----- PROPERTY LINES
-  POND
- STREAM

POND POSITION RELATIVE TO 1/4 CORNER
BASED ON GPS & CONVENTIONAL SURVEY

RECEIVED

JAN 26 2012

WATER RESOURCES DEPT
SALEM, OREGON