





# T. 4 N., R. 25 E., W.M.

## FINAL PROOF SURVEY

UNDER

G-7586

G-6876



Application No. 57524 Permit No. 43606

IN NAME OF

ARNOLD BRAAT, MERLE F. & MARY LOU CARLSON, & CONNECTICUT GEN. LIFE INS. CO.

Surveyed OCT. 16, 1985, By V.L. CHURCH

SCALE  
1" = 1320'

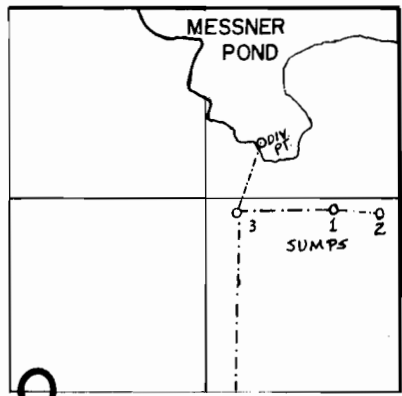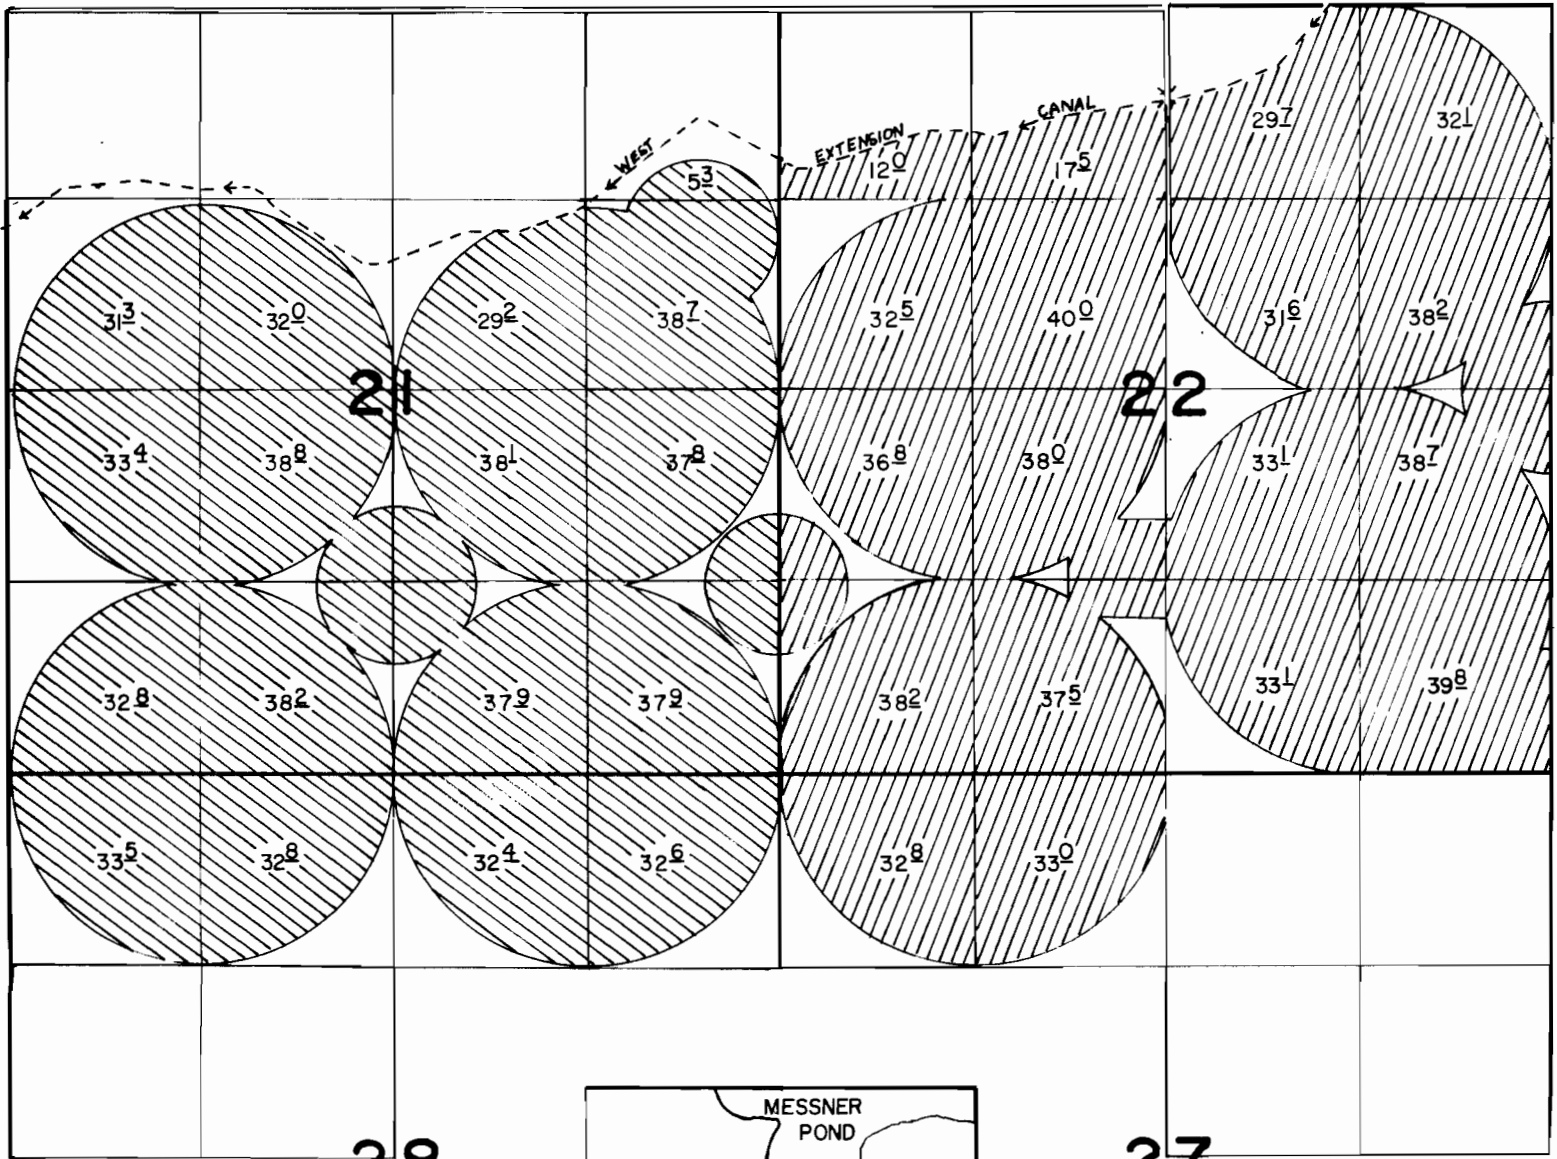

DIV. PT. LOCATED 940'S. AND 950' W.  
FROM NE CORNER SEC. 10

SUMP 3 LOCATED 1430'S. AND 1120' W.  
FROM NE CORNER SEC. 10

SUMP 2 LOCATED 1250' N. & 100' W.

SUMP 1 LOCATED 1300' N. & 440' W.,

BOTH FROM THE E. 1/4 COR. SEC. 10

10



BRAAT, PRIMARY, PER. G-6876  
SUPP. PER. 43606



CARLSON, PRIMARY, PER. G-6876  
SUPP. PER. 43606