


T10S R40E Sections 1 and 12, W.M.

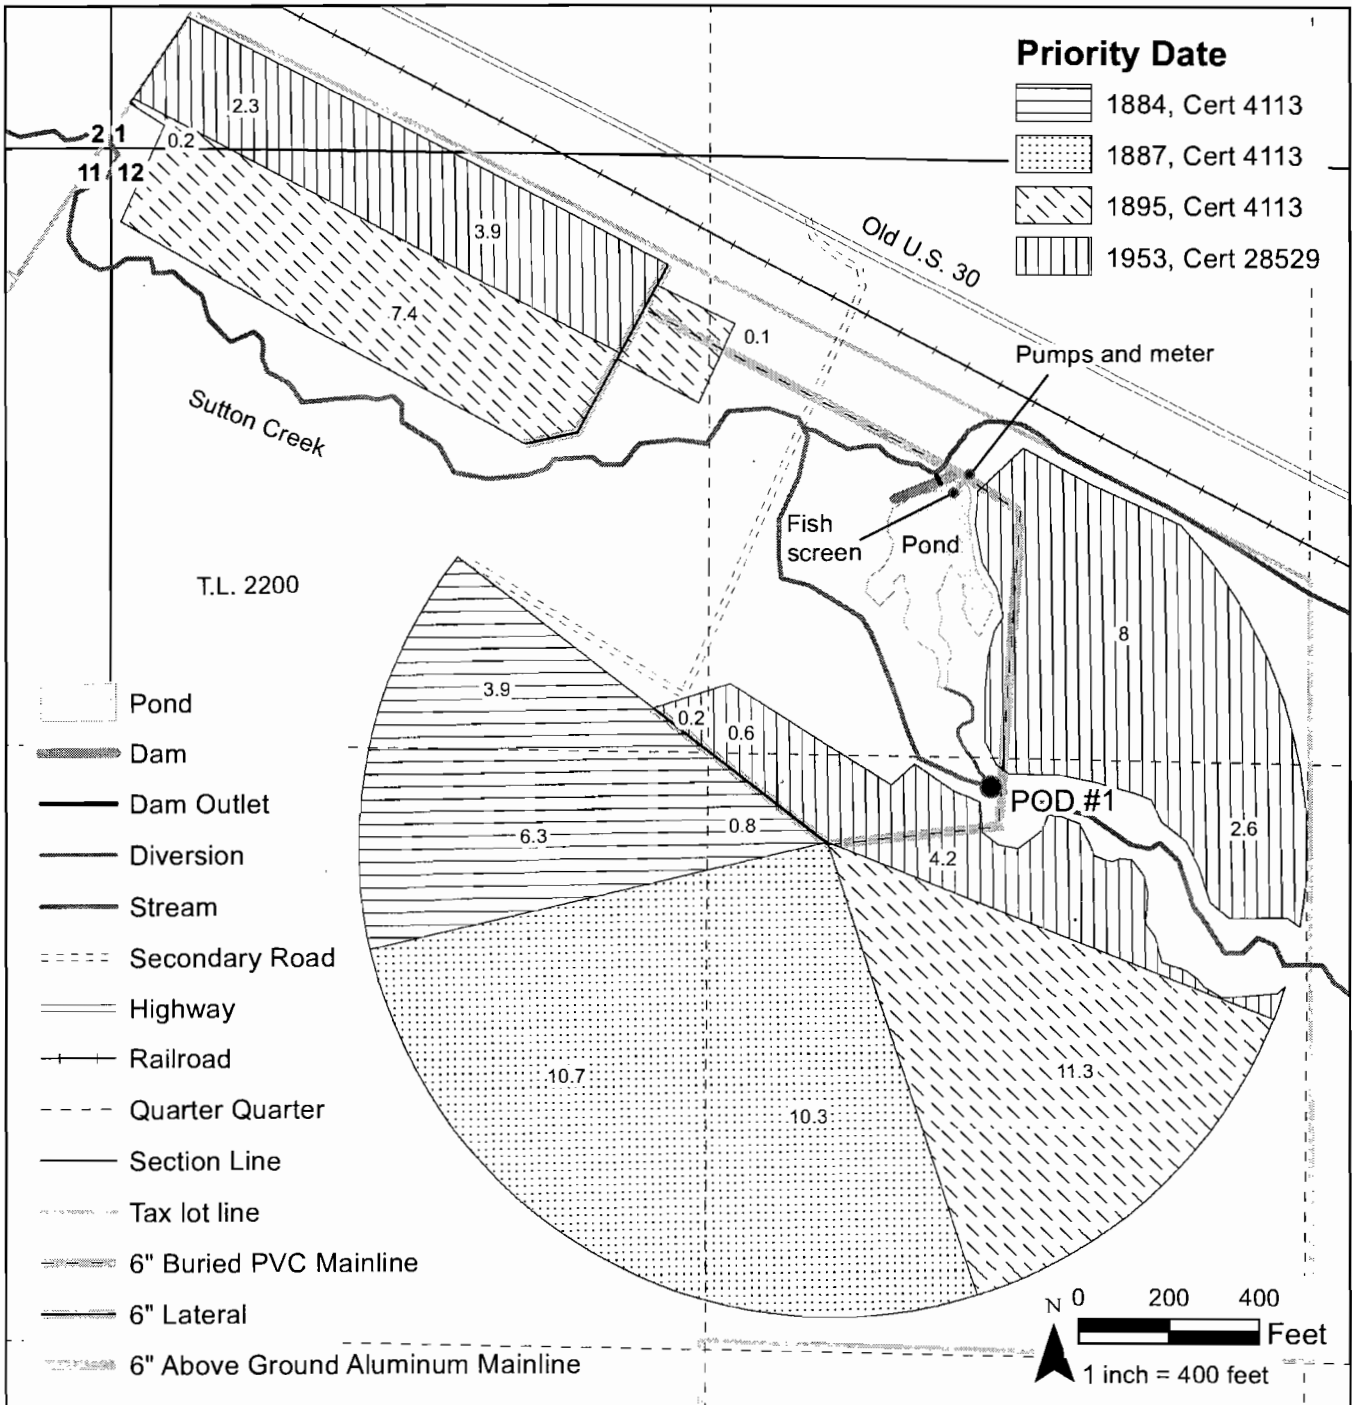

Expires 12/31/2014
Nancy Rorick Consulting

This map is not intended to provide legal dimensions or locations of property ownership lines.

POD # 1 is located 1970 feet east and 1,440 south of the NW corner of Section 12.

RECEIVED BY **Claim of Beneficial Use for T8726**
Tax Lot 2200
Randy and Linda Joseph

007 18 2013

SALEM, OR