


Range 14.E.

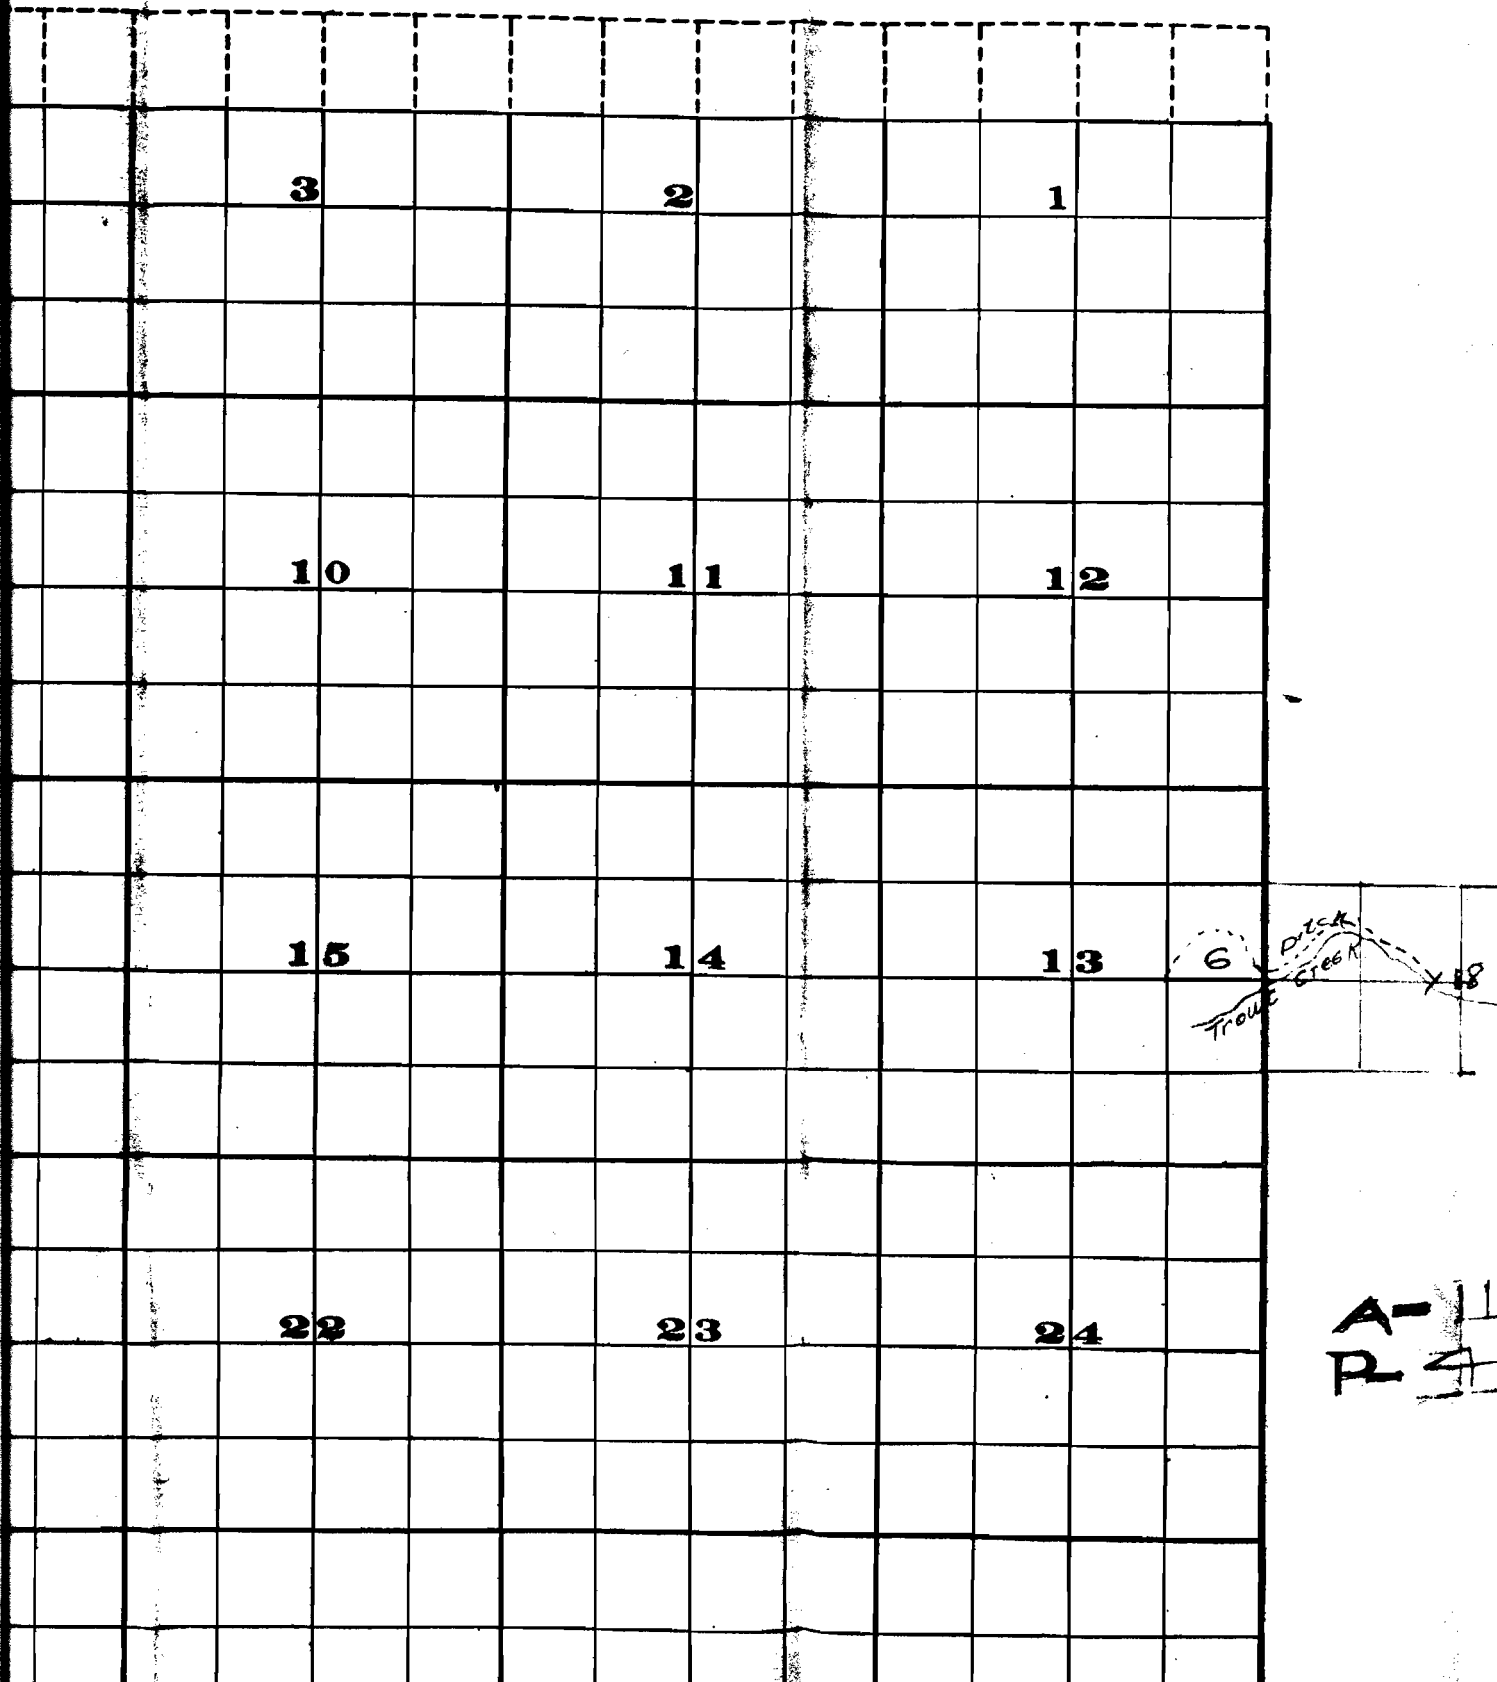

A-1119
P-487