


E-45

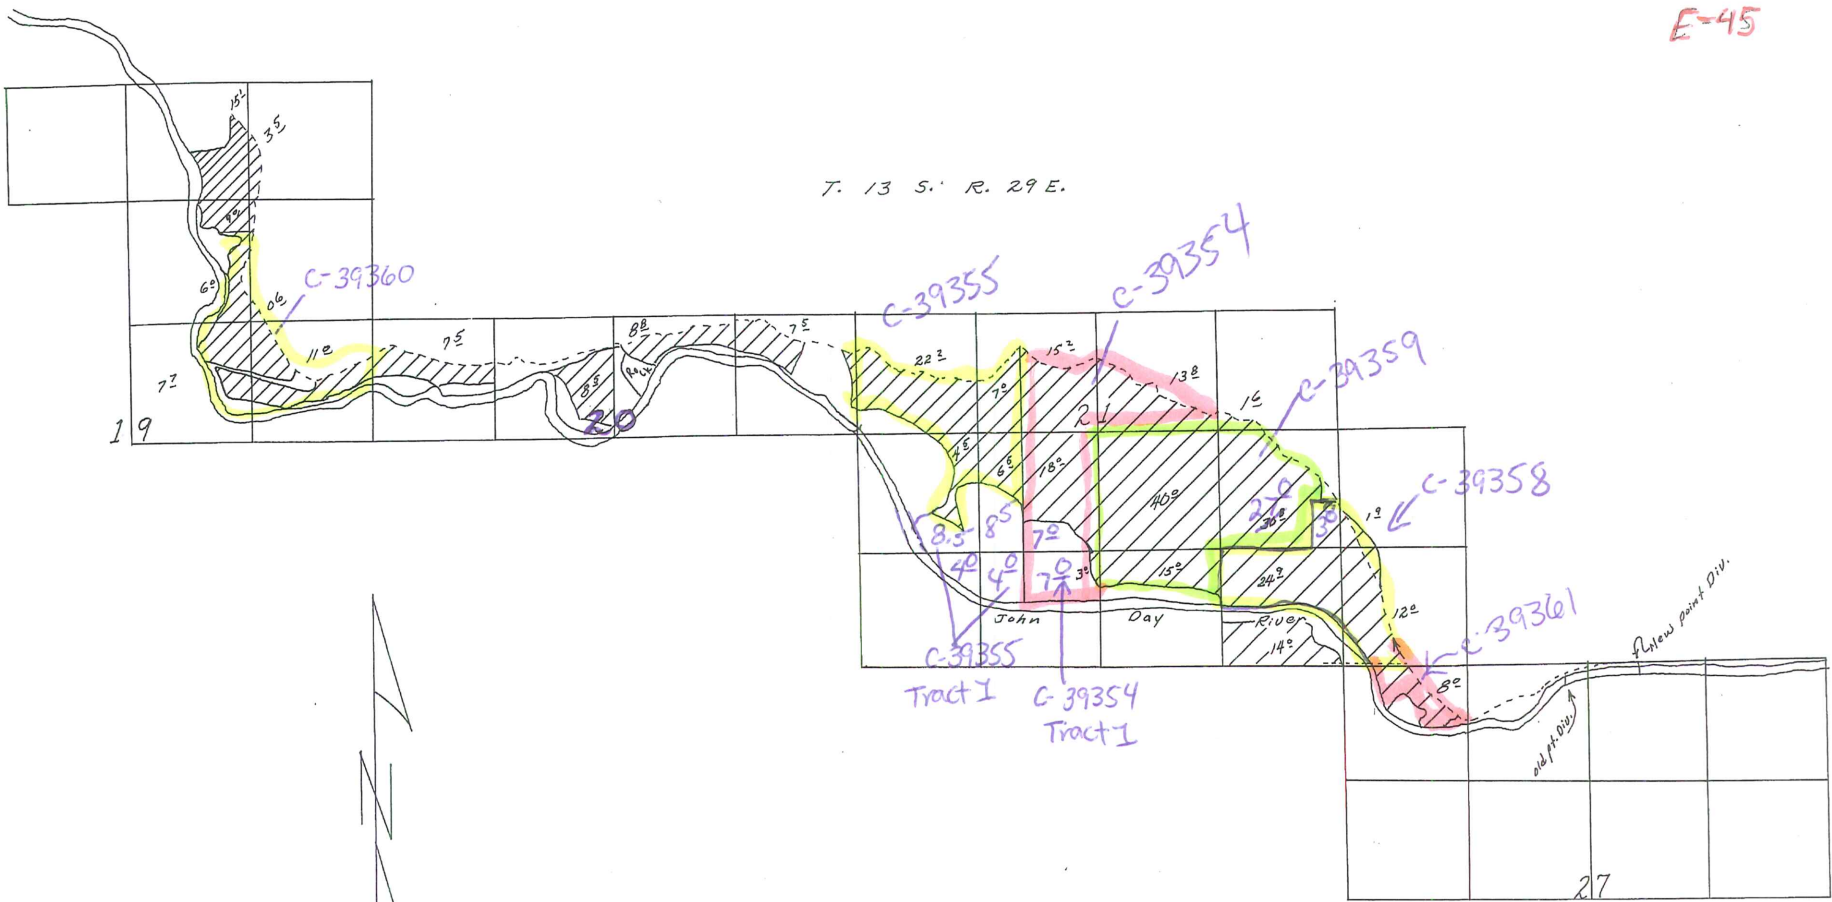

RECEIVED
 JUN 2 1966
 STATE ENGINEER
 PORTLAND, OREGON

Application Map

Scale 4" = Mile