


RECEIVED

NOV 01 2004
WATER RESOURCES DEPT
SALEM, OREGON


T.6S. R.3W. Sec. 4 & 5

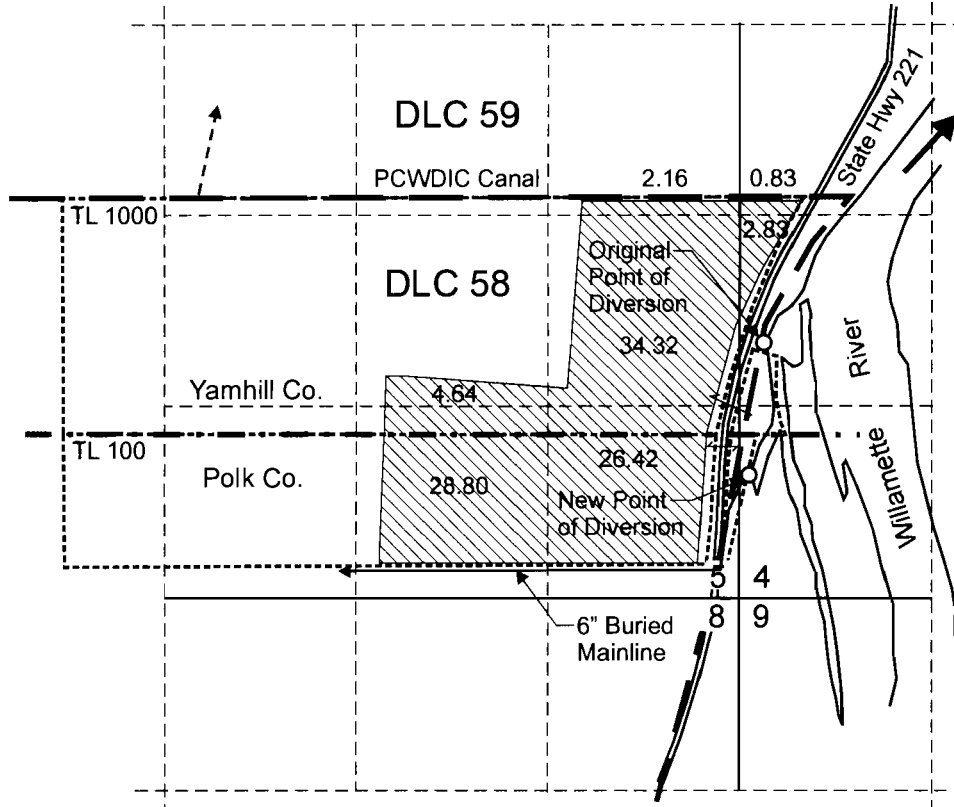

Original point of diversion was located 1,750 feet north and 160 feet east from the southwest corner of Section 4.
 New point of diversion is located 850 feet north and 60 feet east from the southwest corner of Section 4.

 Area (100.00 Acres) irrigated under Transfer T-8694.

----- Tax Lot Boundary

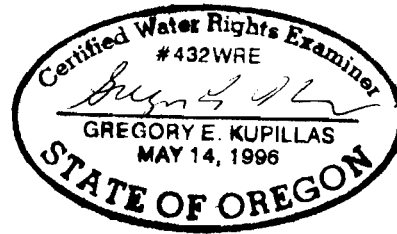

EXPIRATION DATE: 6/20/04

Scale: 1" = 1,320'



This map was prepared for the purpose of identifying the location of a water right only and is not intended to provide legal dimensions or location of property ownership lines.



Claim of Beneficial Use Map

Golden Valley Farms
T.6S. R.3W. Sec. 4 and 5

Pacific Hydro-Geology Inc.

9/2004

GVFCOBU.cdr