

DATED 01-21-04



CLAIM OF BENEFICIAL USE MAP
TERRA MAGIC, INC.
P.O. BOX 3093, LAGRANDE, OREGON, 97850
CERT. 45970
PERMIT 40765
TRANSFER # 8782


FIGURE
1 OF 1

AMENDED:
DATE OF SURVEY: 12/15/03
LAST UPDATED: 1/12/04

RECEIVED
FEB 06 2004
WATER RESOURCES DEPT
SALEM, OREGON

LEGEND
WATER RIGHTS
AUTHORIZED PLACE
OF USE - 200 AC.
CERT. # 45970

1" = 400'
T. 2 S., R. 39 E., W.M.
UNION COUNTY, OREGON

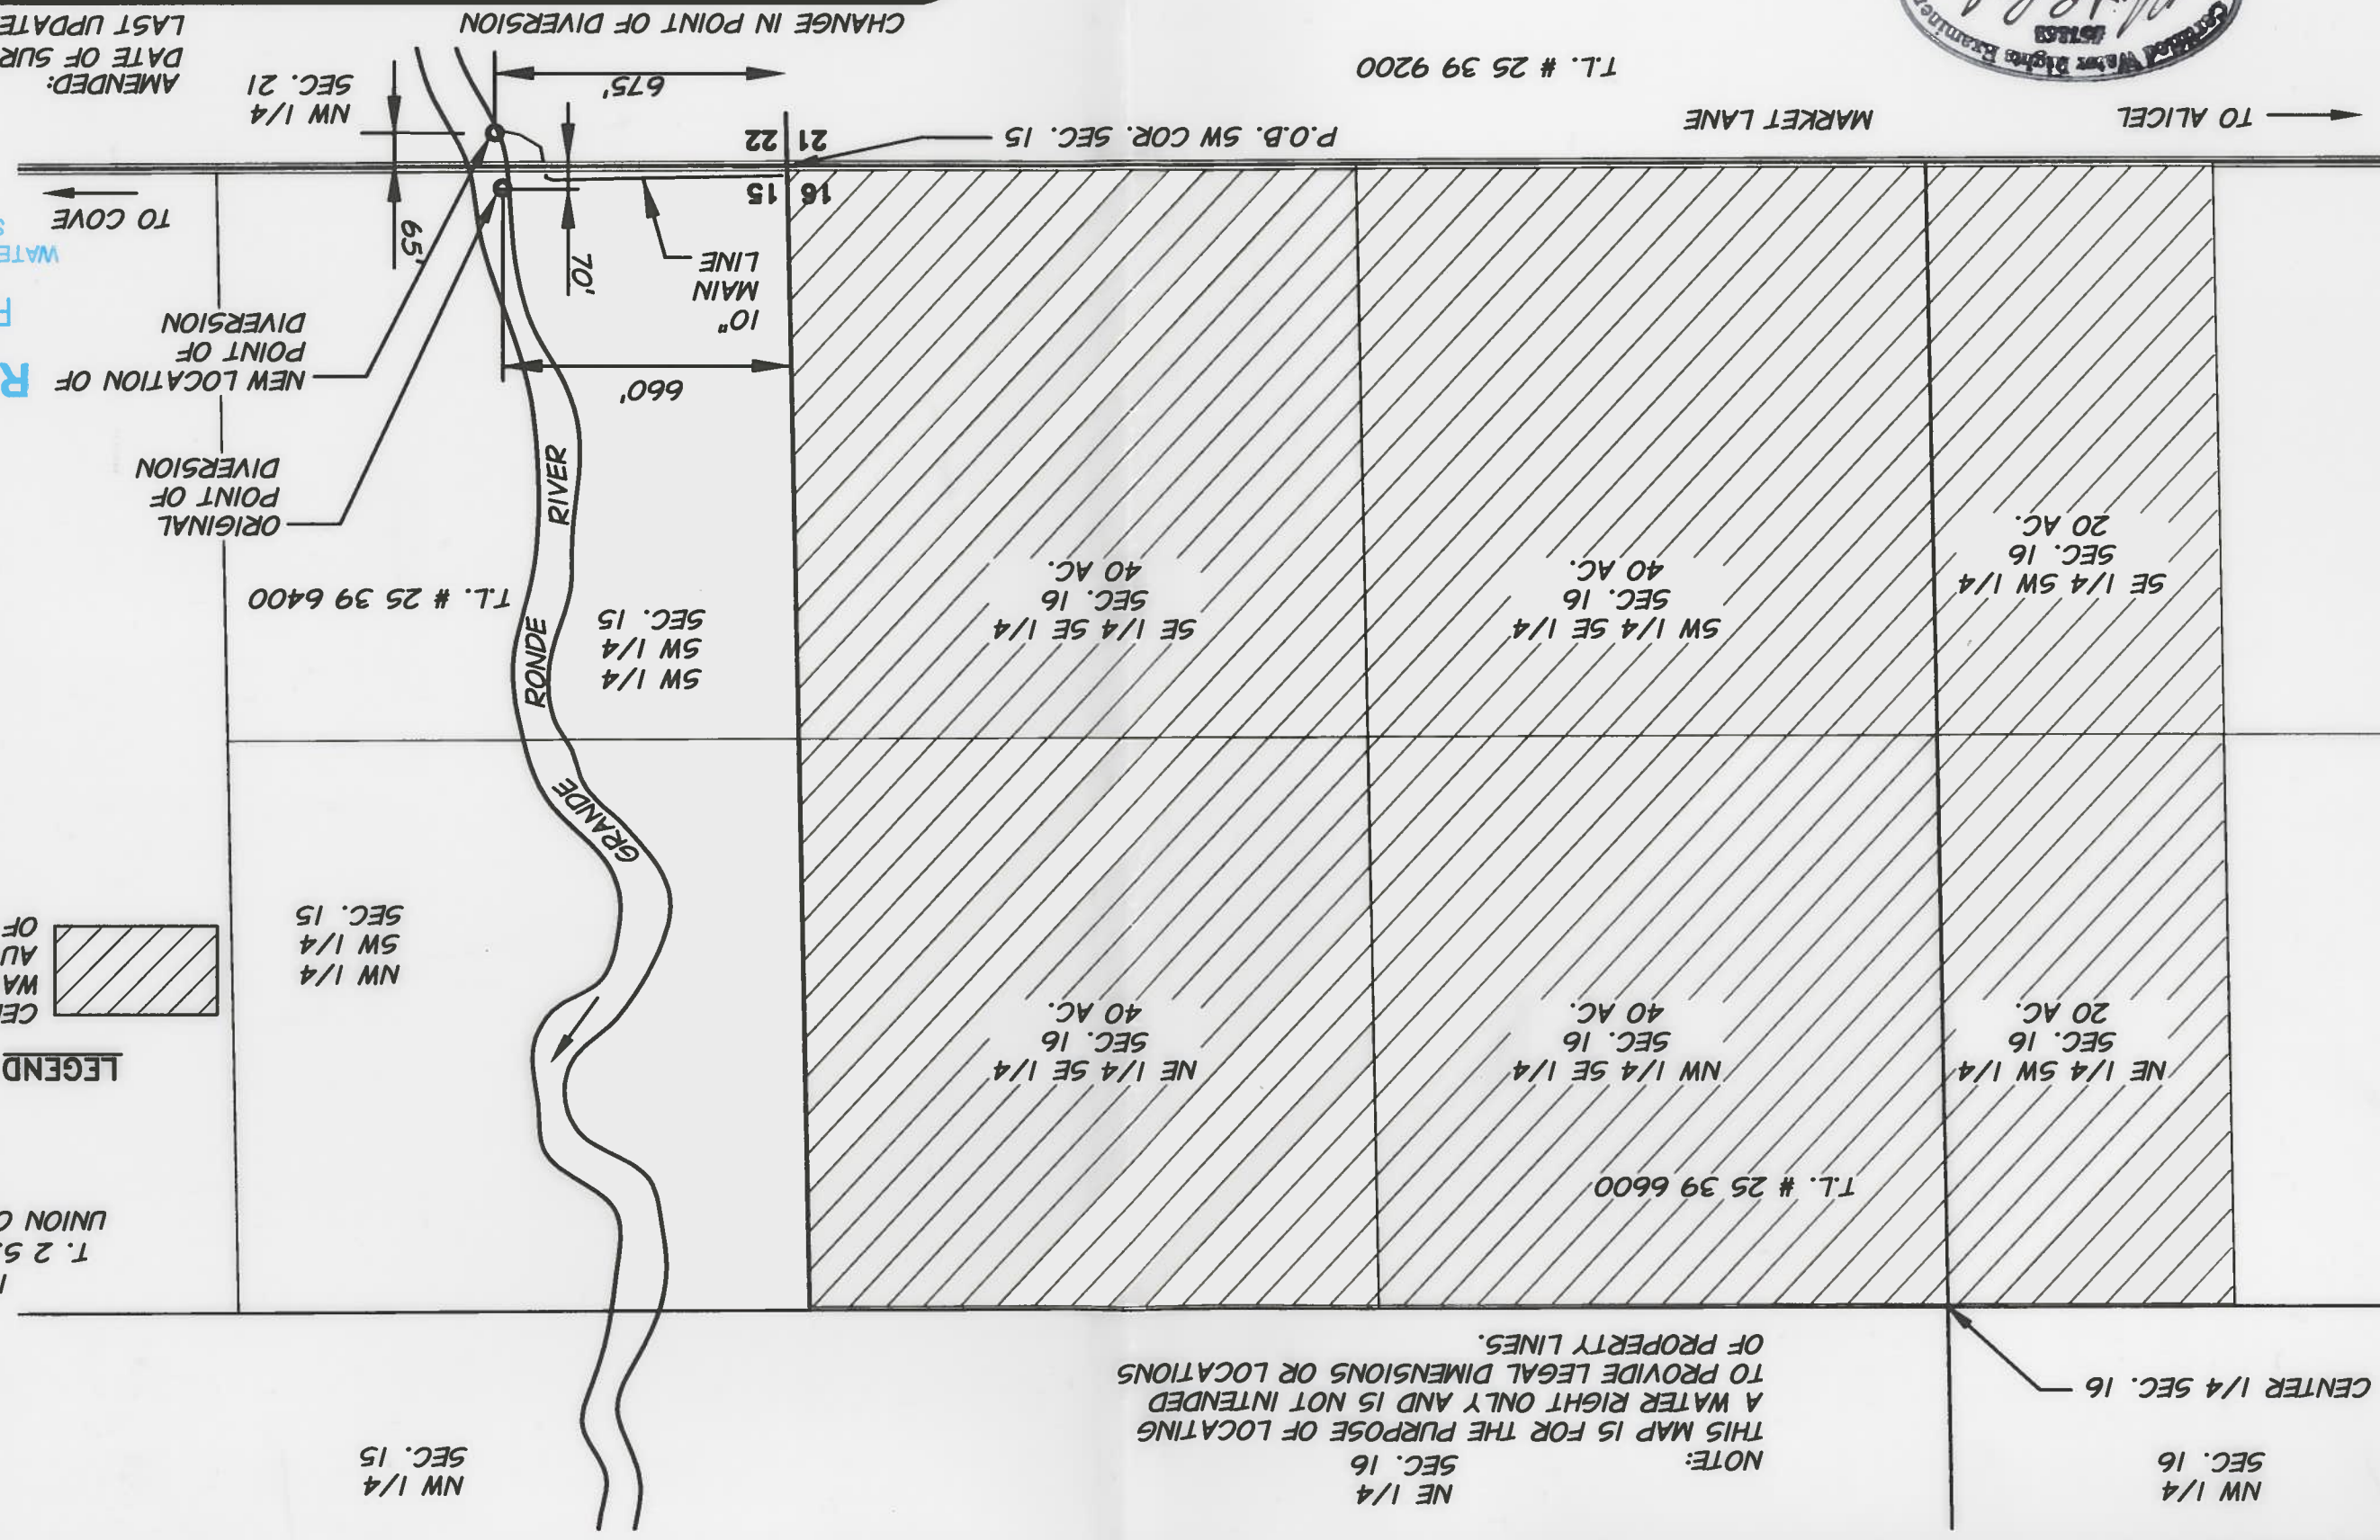

NOTE:
THIS MAP IS FOR THE PURPOSE OF LOCATING
A WATER RIGHT ONLY AND IS NOT INTENDED
TO PROVIDE LEGAL DIMENSIONS OR LOCATIONS
OF PROPERTY LINES.