



T. 16 S., R. 24 E., W. M.

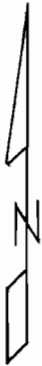



Scale 1"=1320'
(4"=1 mile)

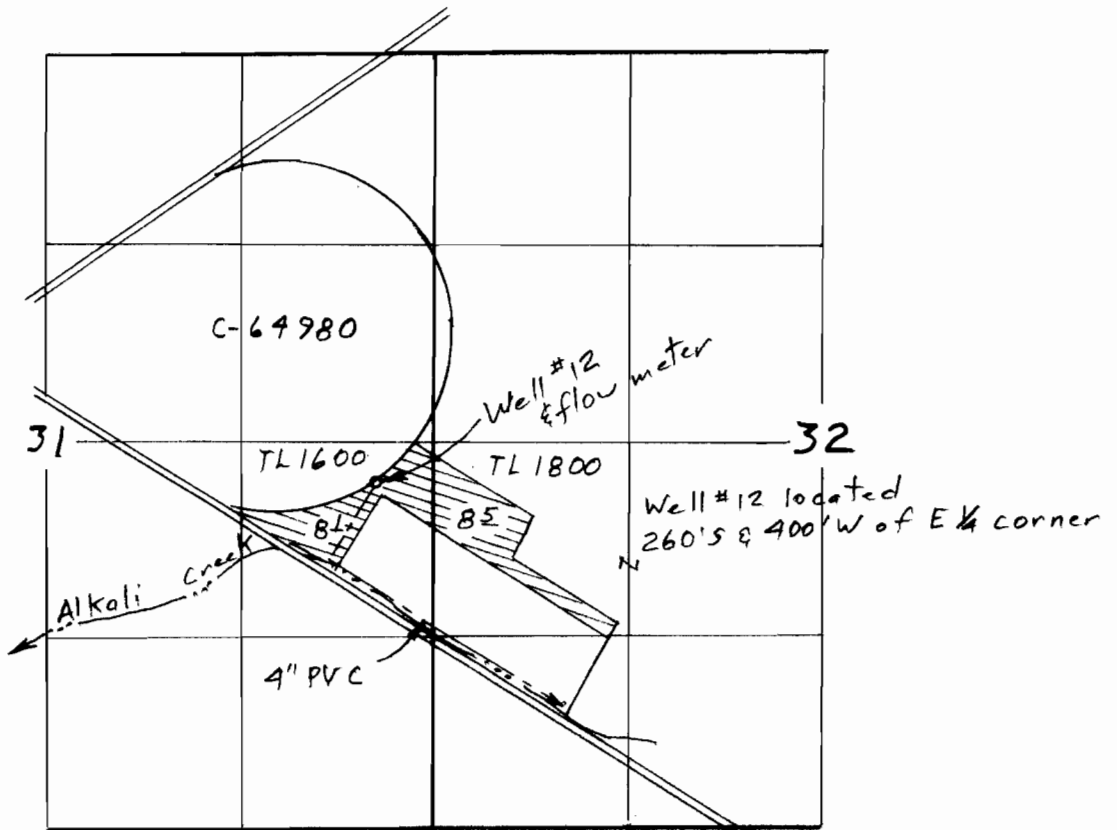

Surveyed July 6, 2009 & Aug 24, 2012

Claim of Beneficial Use Map
for
Hermreck at the Y Ranch, LLC

App G-14875
Per G-13724

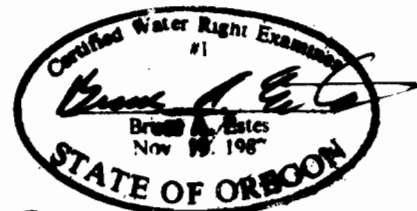 

Renewal Dec 31, 2013

This map is for the purpose of locating a water right only and has no intent to provide legal dimensions or the location of property lines.

ESTES SURVEYS, LLC

PO-Box 17519	60382 Arnold Rd
Salem, OR 97305-7519	Bend, OR 97702
(503) 565-7585	(541) 382-7391