


4-00

PARCEL

NO.

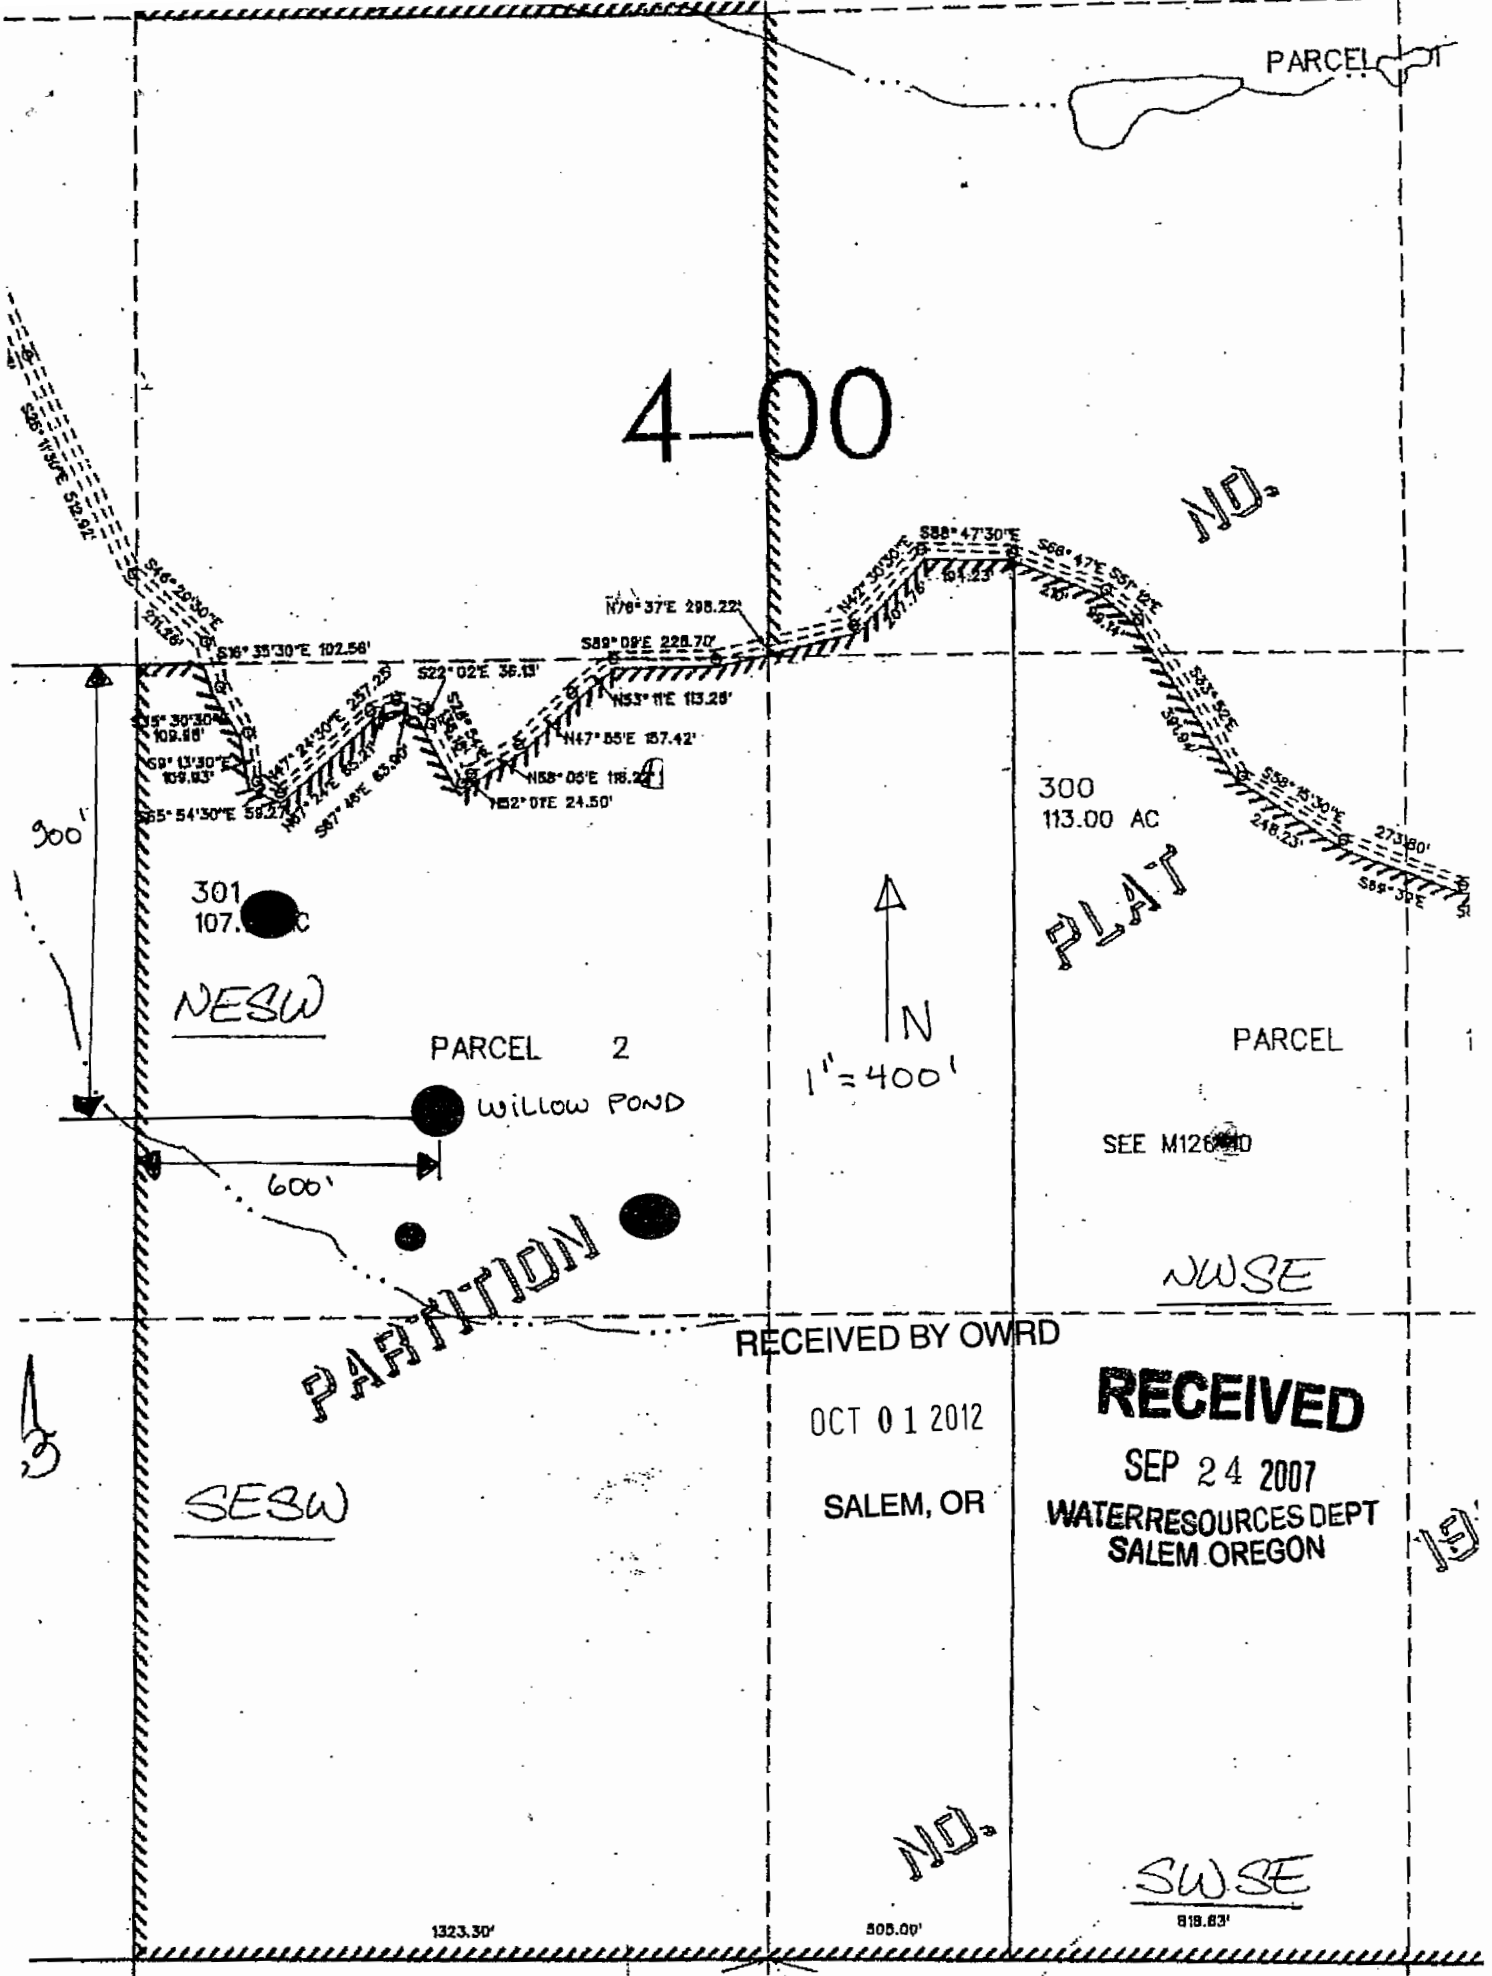

PARTITION

RECEIVED BY OWRD


OCT 01 2012
SALEM, OR

RECEIVED
SEP 24 2007
WATER RESOURCES DEPT
SALEM OREGON

NO.

SWSE

App No R 86990 Permit No R 14596

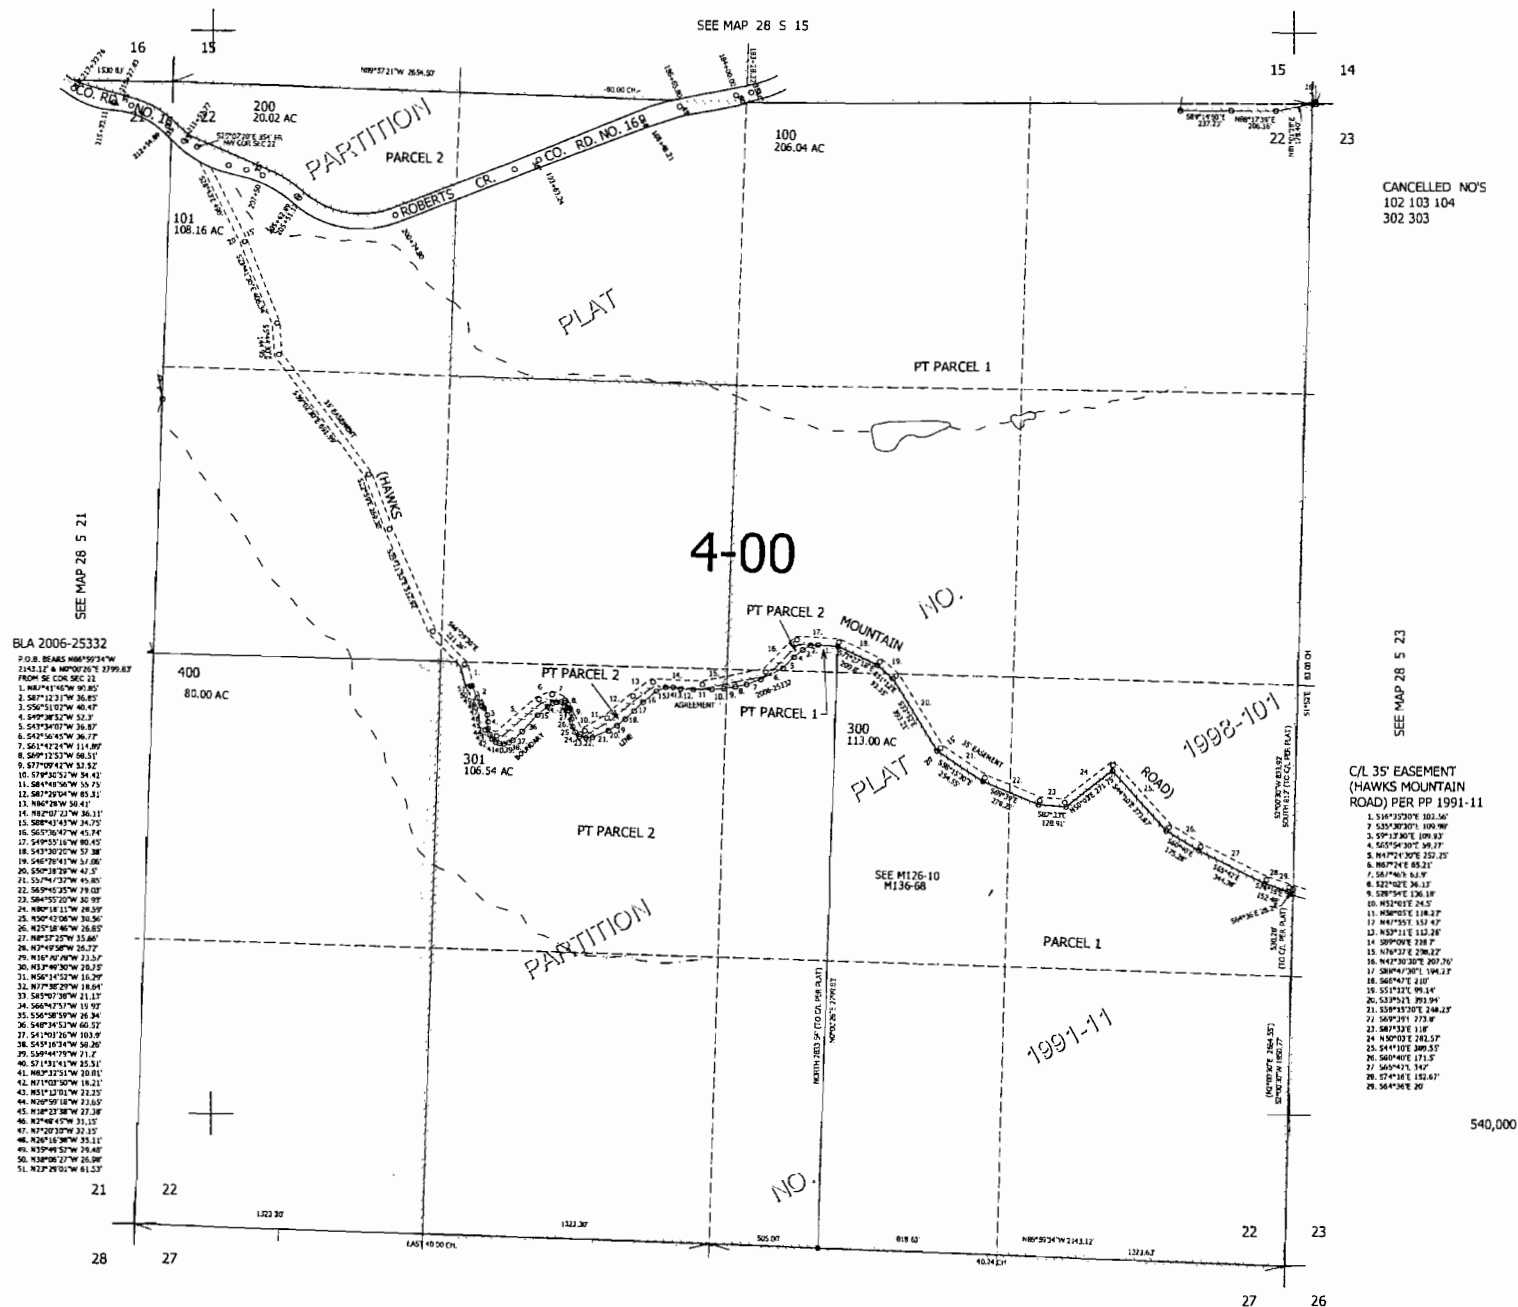$1'' = 400'$ 

AppNo R86990 Permit No R14596