
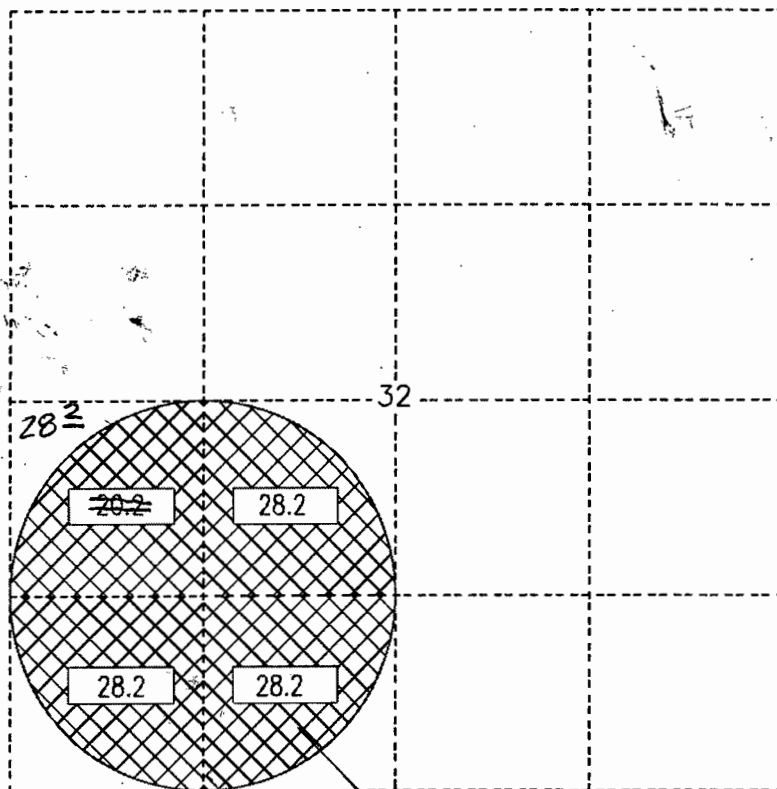


RECEIVED

JUL 30 1999

WATER RIGHTS TRANSFER T-6873
ROBERT L. OSTER
CHRISTMAS VALLEY, OREGON


WATER RESOURCES DEPT.
SALEM, OREGON

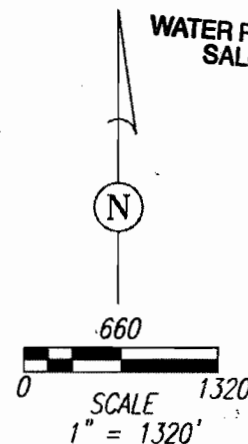

Irrigated area areas noted.
Well is located 60 ft. north and 1320 ft. east
of the southwest corner of Section ~~32~~ 32



I, Joel G. Smith, Certified Water Rights Examiner No. 120, do
hereby certify that this map was prepared under my direction.
This map has been prepared to identify the location of a
water right and does not represent property ownership or
boundary lines.

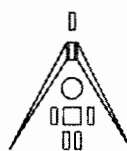

TERRASCOPE, INC.
405 SW Eighth St
Redmond, OR 97756
Tel: (541) 548-7852
Fax: (541) 548-7854

FINAL PROOF SURVEY
SEC 32, T26S, R19E, WM
LAKE COUNTY, OR

DRAWING NO: F602-2
DATE: 4/28/99
DRAWN BY: GLJ
CHECKED BY: JGS
PROJECT NO: F117-600

acreage adjusted by WRD 10/30/2013 DL