

FOR ASSESSMENT
AND TAXATION
ONLY


SEC.27 T.16S. R.5W. W.M.
DETAIL MAP NO. 1
LANE COUNTY

SCALE 1" = 400' (note: original county map provided a scale of
1"=200'. Scale has been changed for smaller map.)
SEE MAP 16 05 22

DATE	REVISION	EMPLOYEE
05/27/16	REV. MAP NO. 1	LANE
05/27/16	REV. MAP NO. 1	LANE
16 05 27
DETAIL MAP NO. 1
C.A.D. SYS.

RECEIVED
APR 09 2012
WATER RESOURCES DEPT
SALEM, OREGON

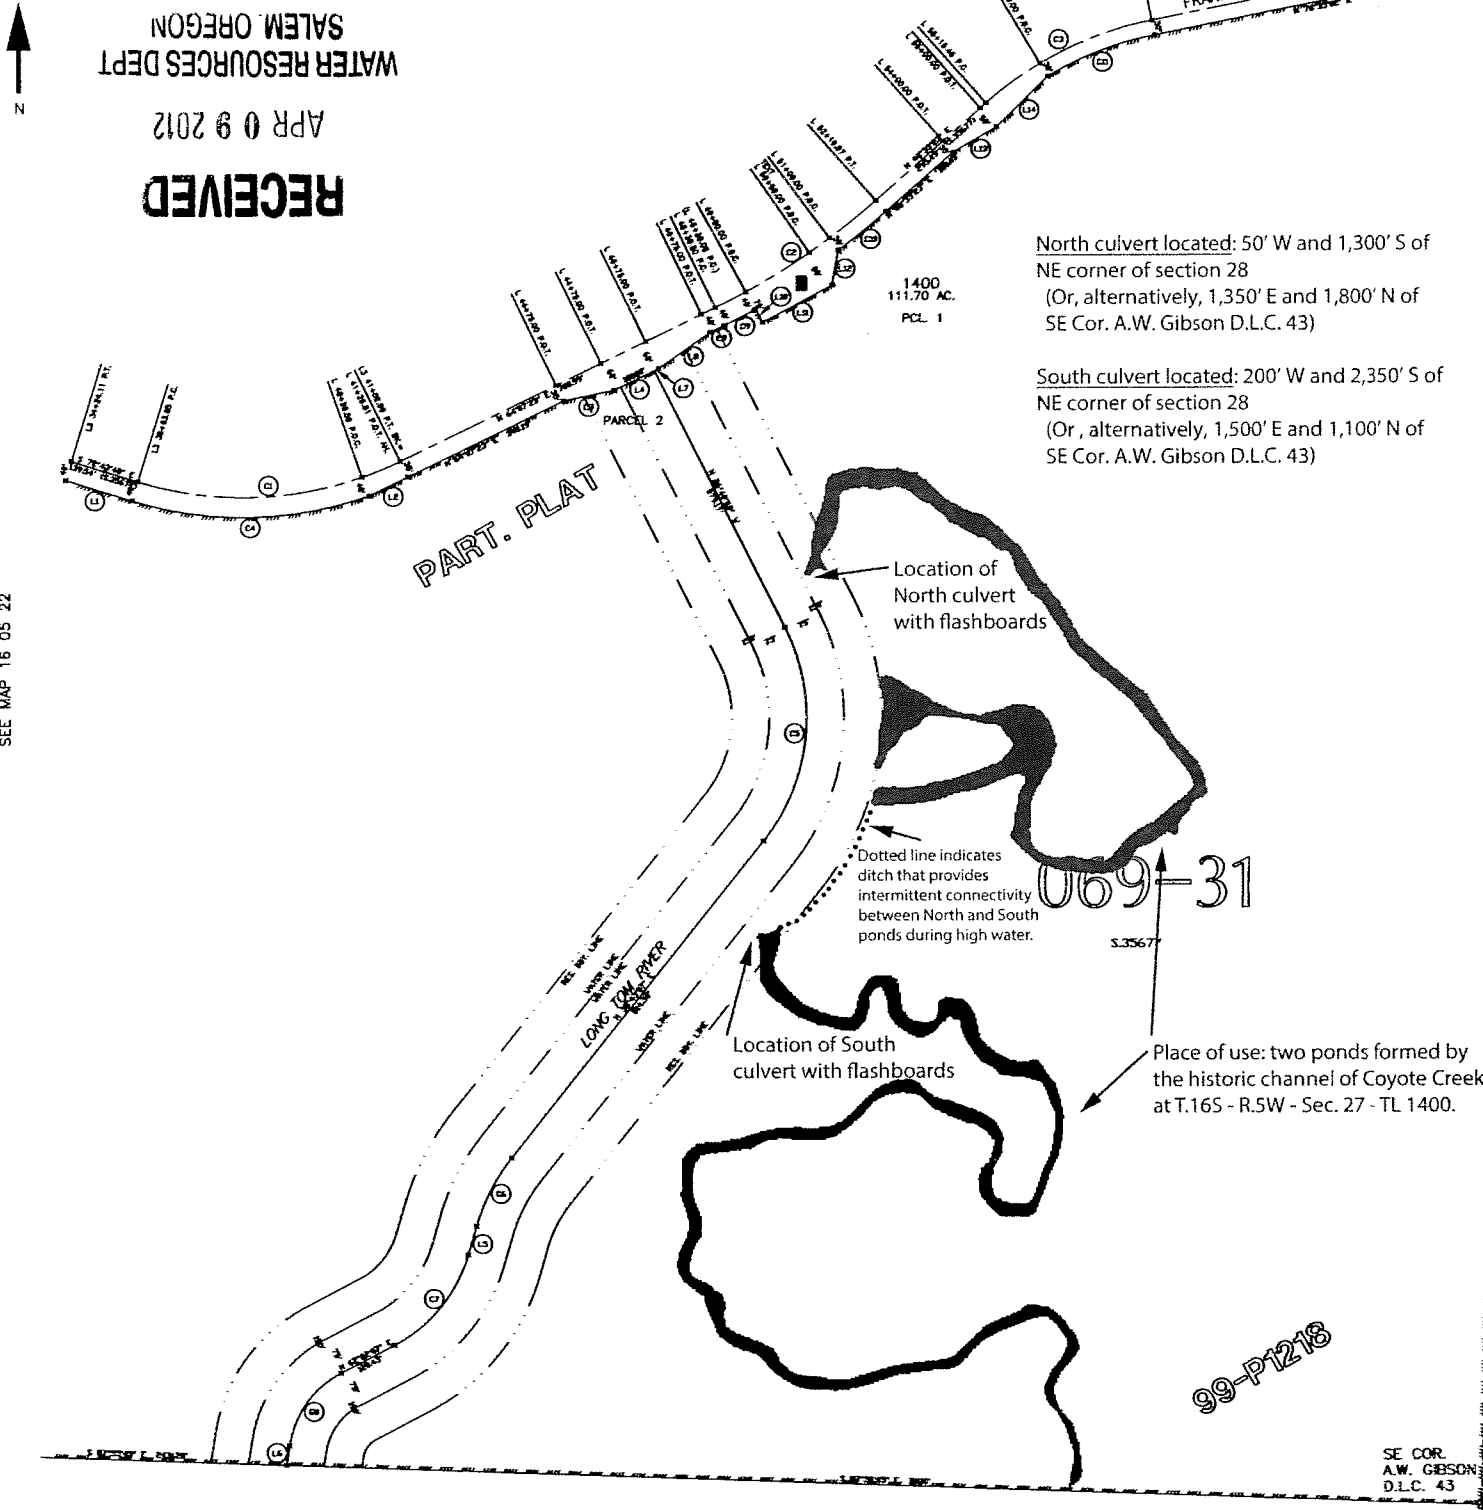





16 05 27
DETAIL MAP NO. 1