


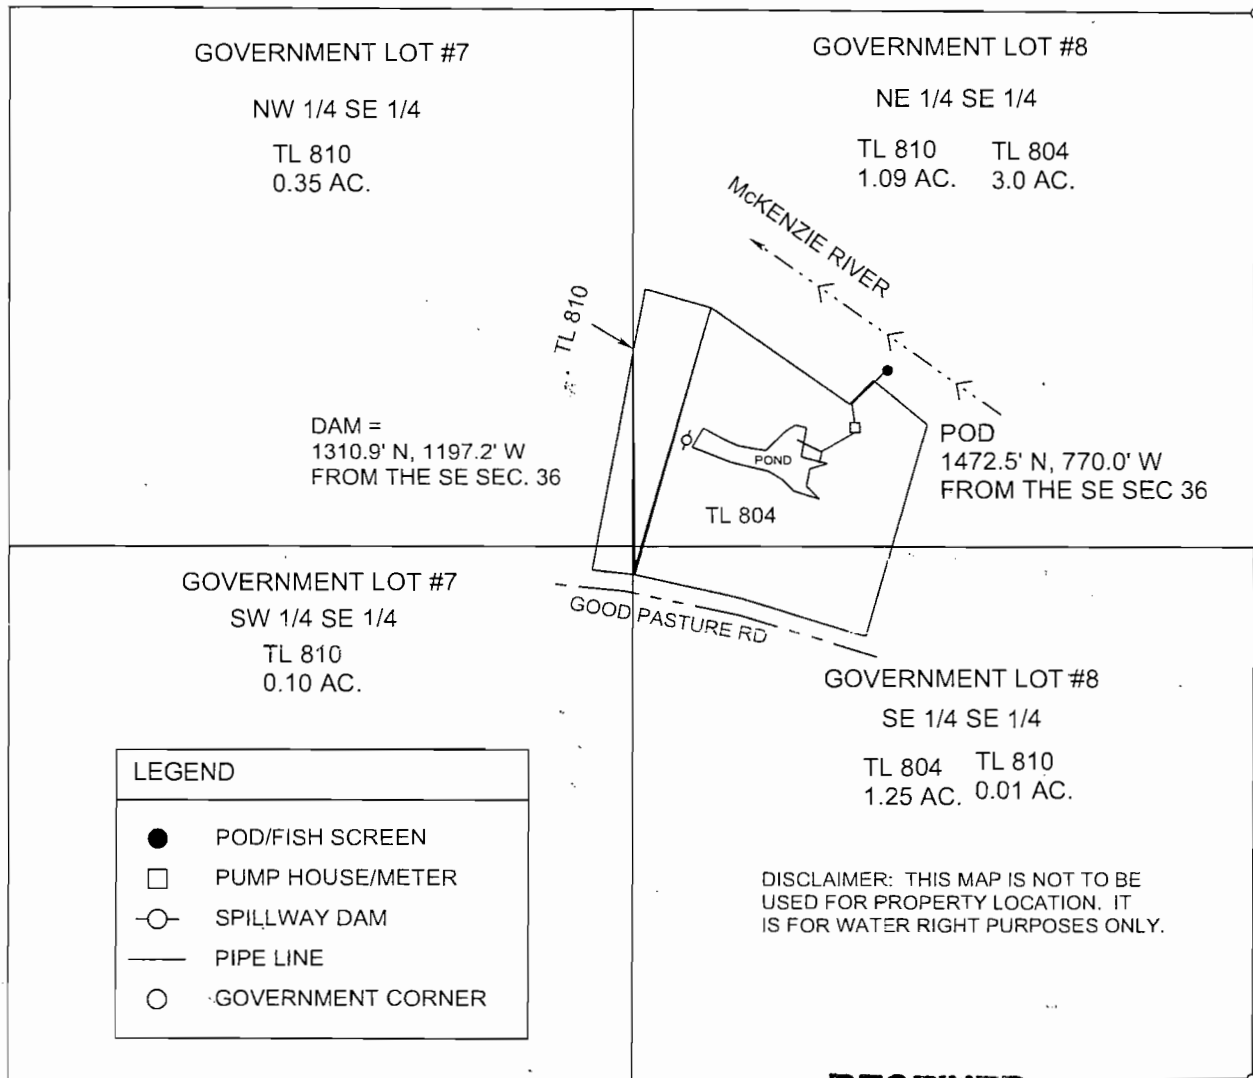

WATER RIGHT CLAIM OF BENEFICIAL USE MAP
FOR
CARPENTER TRUST
LOCATED IN THE
SE 1/4 OF SECTION 36
TOWNSHIP 16 SOUTH, RANGE 2 EAST, W.M.
TAX LOTS 804 & 810
LANE COUNTY OREGON
JANUARY 10, 2012
APP # R-86635, PERMIT # R-14379



EAST 1/4
SECTION 36



RECEIVED

APR 26 2012

WATER RESOURCES DEPT
SALEM, OREGON

SE
SECTION 36