


T8N R8W SEC 26 WM
CLATSOP COUNTY

Scale 1:4800

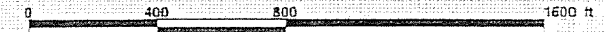


NAD 1983/91 HARN State Plane Oregon North FIPS 3601 InFoot

Additional Detail Maps on Separate Sheets

Cancelled
Accounts

- 1600
- 162
- 169
- 1700
- 1702
- 1703
- 990


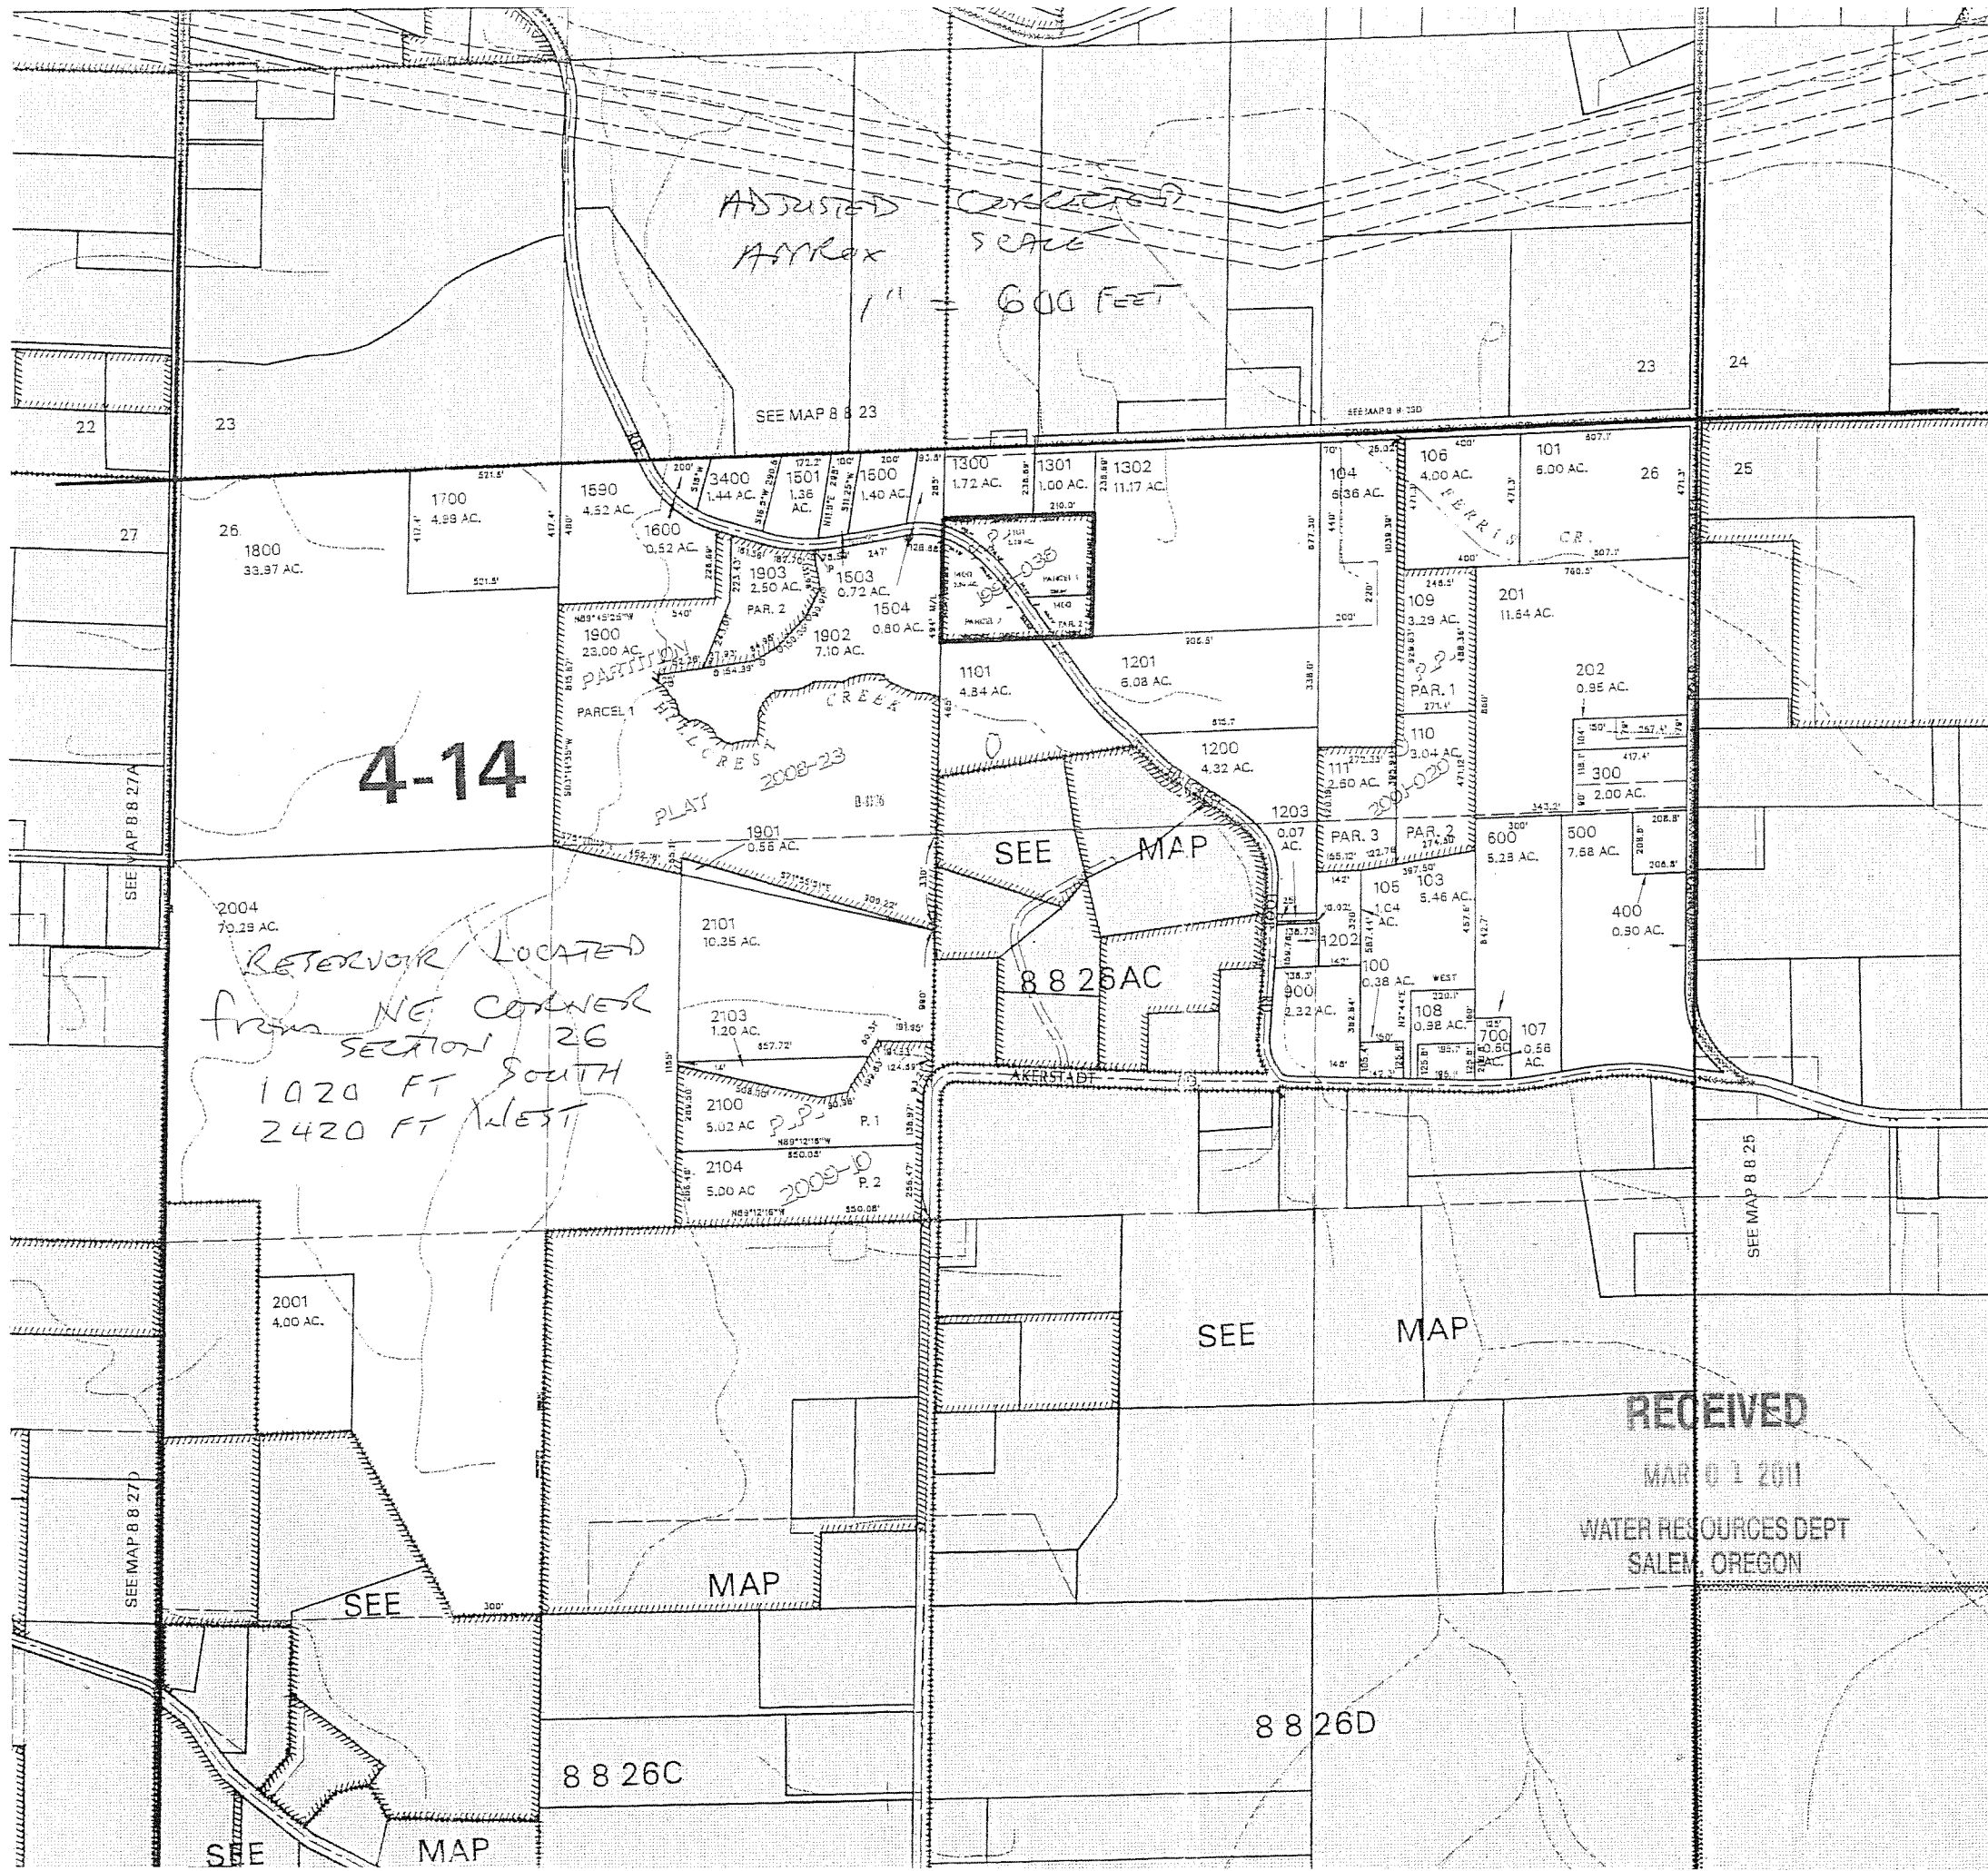


RECEIVED

MAR 01 2011

WATER RESOURCES DEPT
SALEM, OREGON

											31
1	6	5	4	3	2	1	6				
12	7	8	9	10	11	12	7				
13	18	17	16	15	14	13	18				
24	19	20	21	22	23	24	19				
25	30	29	28	27	26	25	30				
36	31	32	33	34	35	36	31				
1	6	5	4	3	2	1	6				

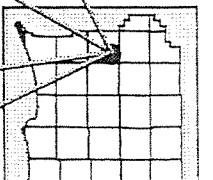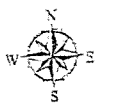

R-87574