

T 34s R 6w S 36 JOSEPHINE CO

RECEIVED

also was prepared for
purpose only.

RECEIVED BY OWRD


DEC - 2 1996

NOV 30 2012


WATER RESOURCES DEPT
SALEM, OREGON

SALEM, OR

SEE MAP 34 6

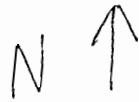

1" = 400'

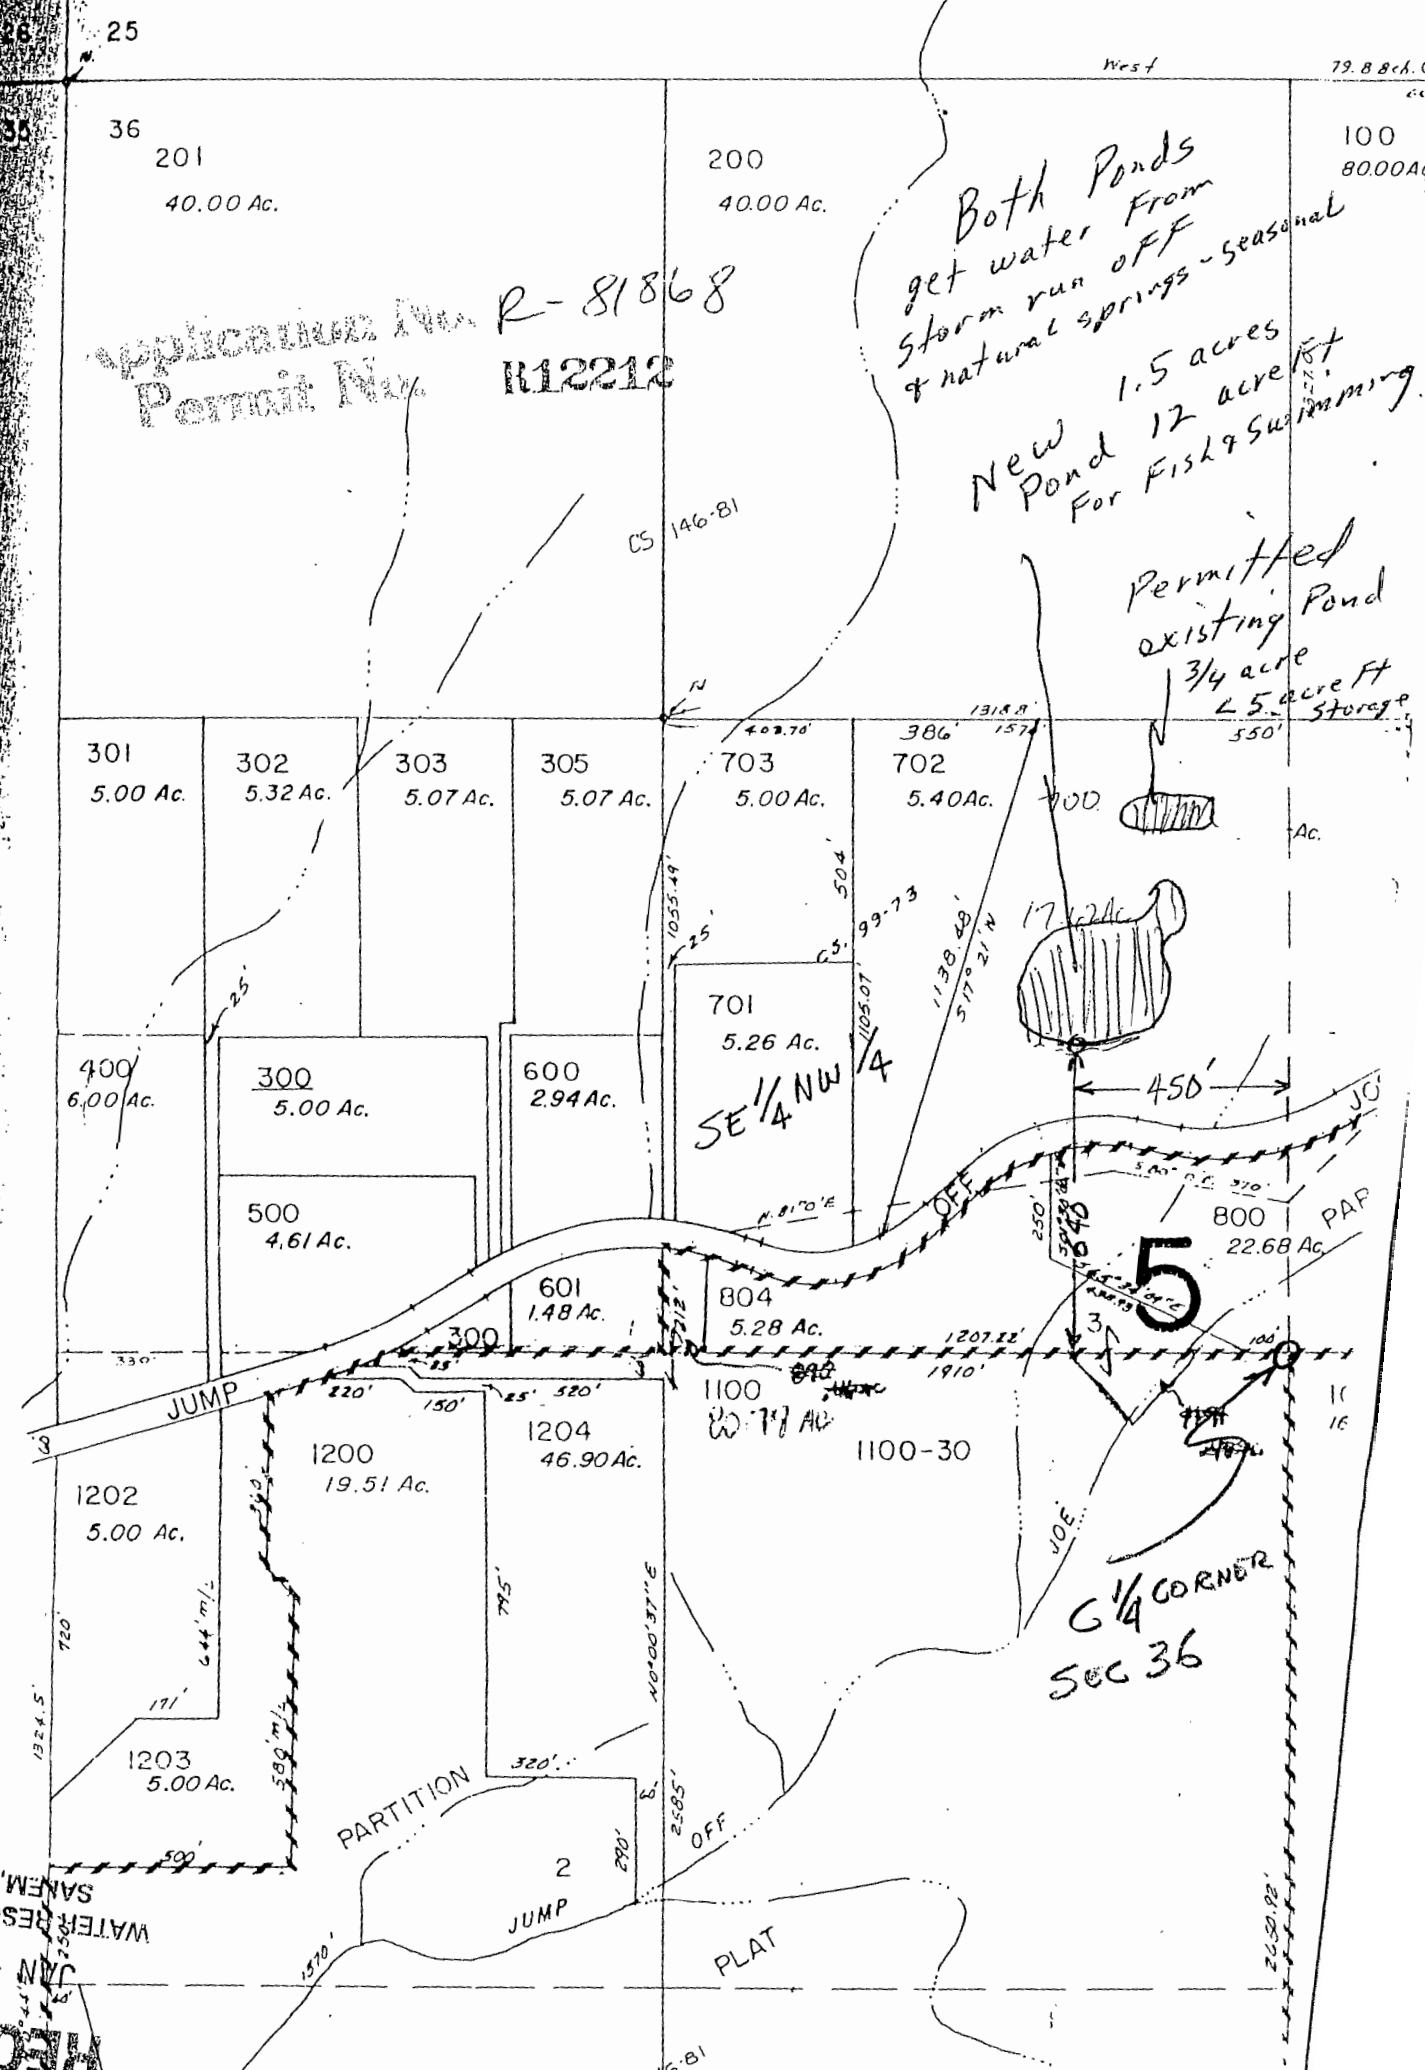

SEE MAP 34

WATER RESOURCES
SALEM, OREGON
JAN - 3 1996

RECEIVED