


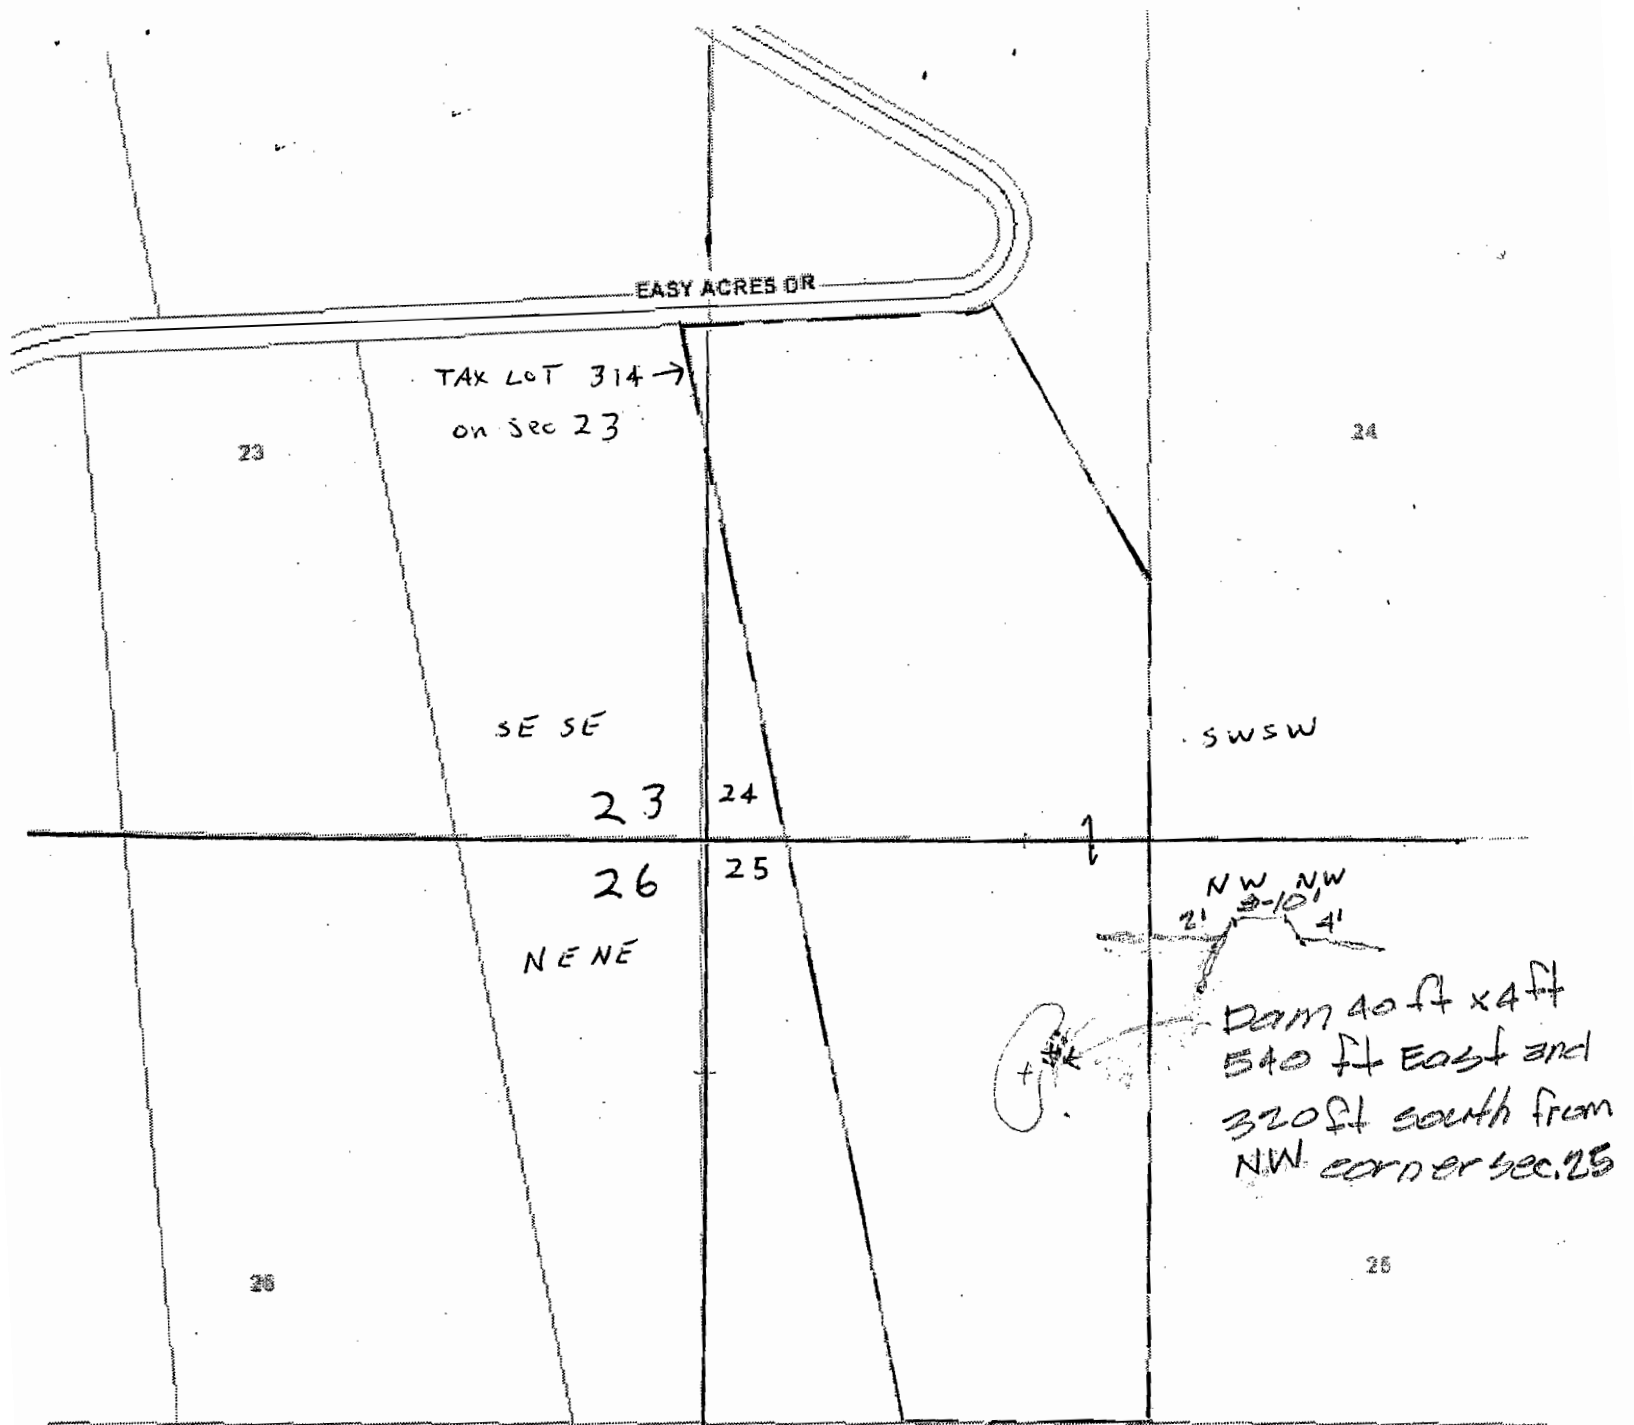

Tax Map lot 19052300 00314

N
1" = 300'

T 19 S R 5 W Sec 25

NW 1/4, NW 1/4

350 ft south and

500 ft East from

SE corner Sec 23

RECEIVED

APR 05 2011

WATER RESOURCES DEPT
SALEM, OREGON