

BENEFICIAL USE/FINAL MAP

APPLICATION NO. 73182 PERMIT NO. 11678

FOR

JOSEPH STAPERFENNE AND SARA HICKS


41950 S.E. COLEMAN ROAD

SANDY, OR 97055

TAX LOT 1008 LOCATED ALL WITHIN THE
N.E. 1/4 OF THE S.E. 1/4 OF SECTION 18,
TOWNSHIP 2 SOUTH, RANGE 5 EAST, W.M.
CLACKAMAS COUNTY, OREGON

SCALE: 1"=100' MAY 1, 2011

THIS DRAWING IS AN EXHIBIT FOR AN APPLICATION
TO PERMIT AN EXISTING RESERVOIR. IT IS NOT A
LAND SURVEY. PROPERTY LINES AND/OR OTHER
LINES OF OCCUPATION SHOWN HEREON ARE NOT
REPRESENTED BY THE UNDERSIGNED TO MEET
ACCURACY STANDARDS OF LAND SURVEYS.

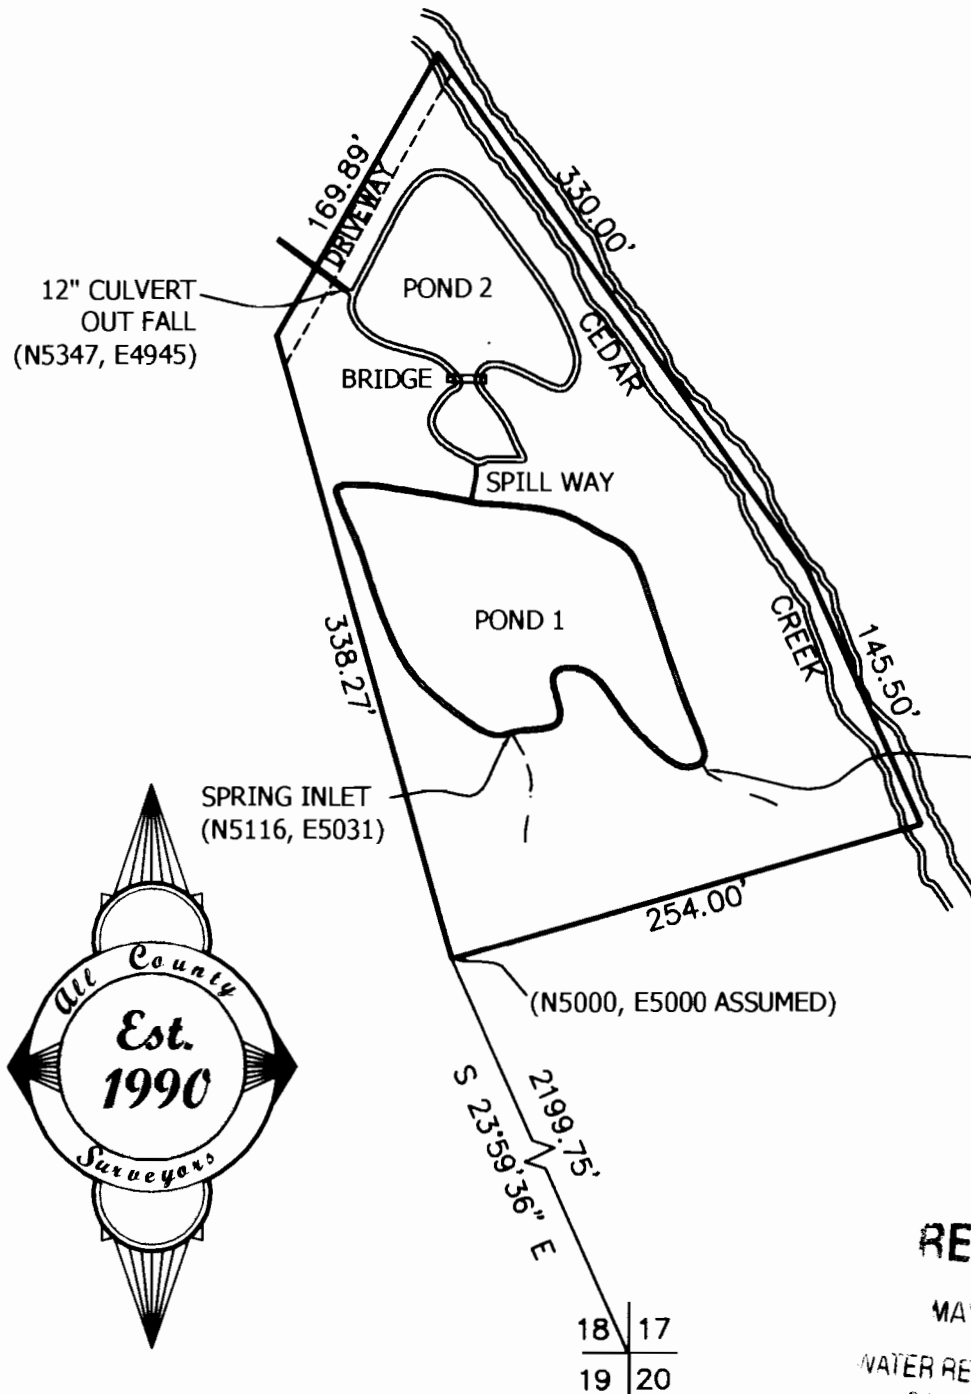

RECEIVED

MAY 2 2011

WATER RESOURCES DEPT
SALEM, OREGON



JOB # 11-004