



RECEIVED

APR 22 2011

WATER RESOURCES DEPT  
SALEM, OREGON

SCALE: 1" = 600'

NOTE: THE PREPARATION OF THIS MAP  
WAS FOR THE PURPOSE OF IDENTIFYING  
THE LOCATION OF THE PROPOSED WATER  
RIGHT, AND HAS NO INTENT TO PROVIDE  
DIMENSIONS OR LOCATIONS OF PROPERTY  
OWNERSHIP LINES.

— LEGEND —


FOUND ALUM. MONUMENT

Final Proof Map  
for  
Storage Reservoir

R - 12591


for  
Ochoco West Water and  
Sanitary Authority

by

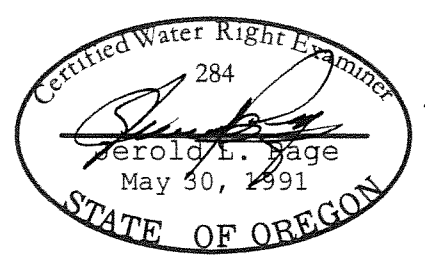

Renew 12-31-12

3-21-11

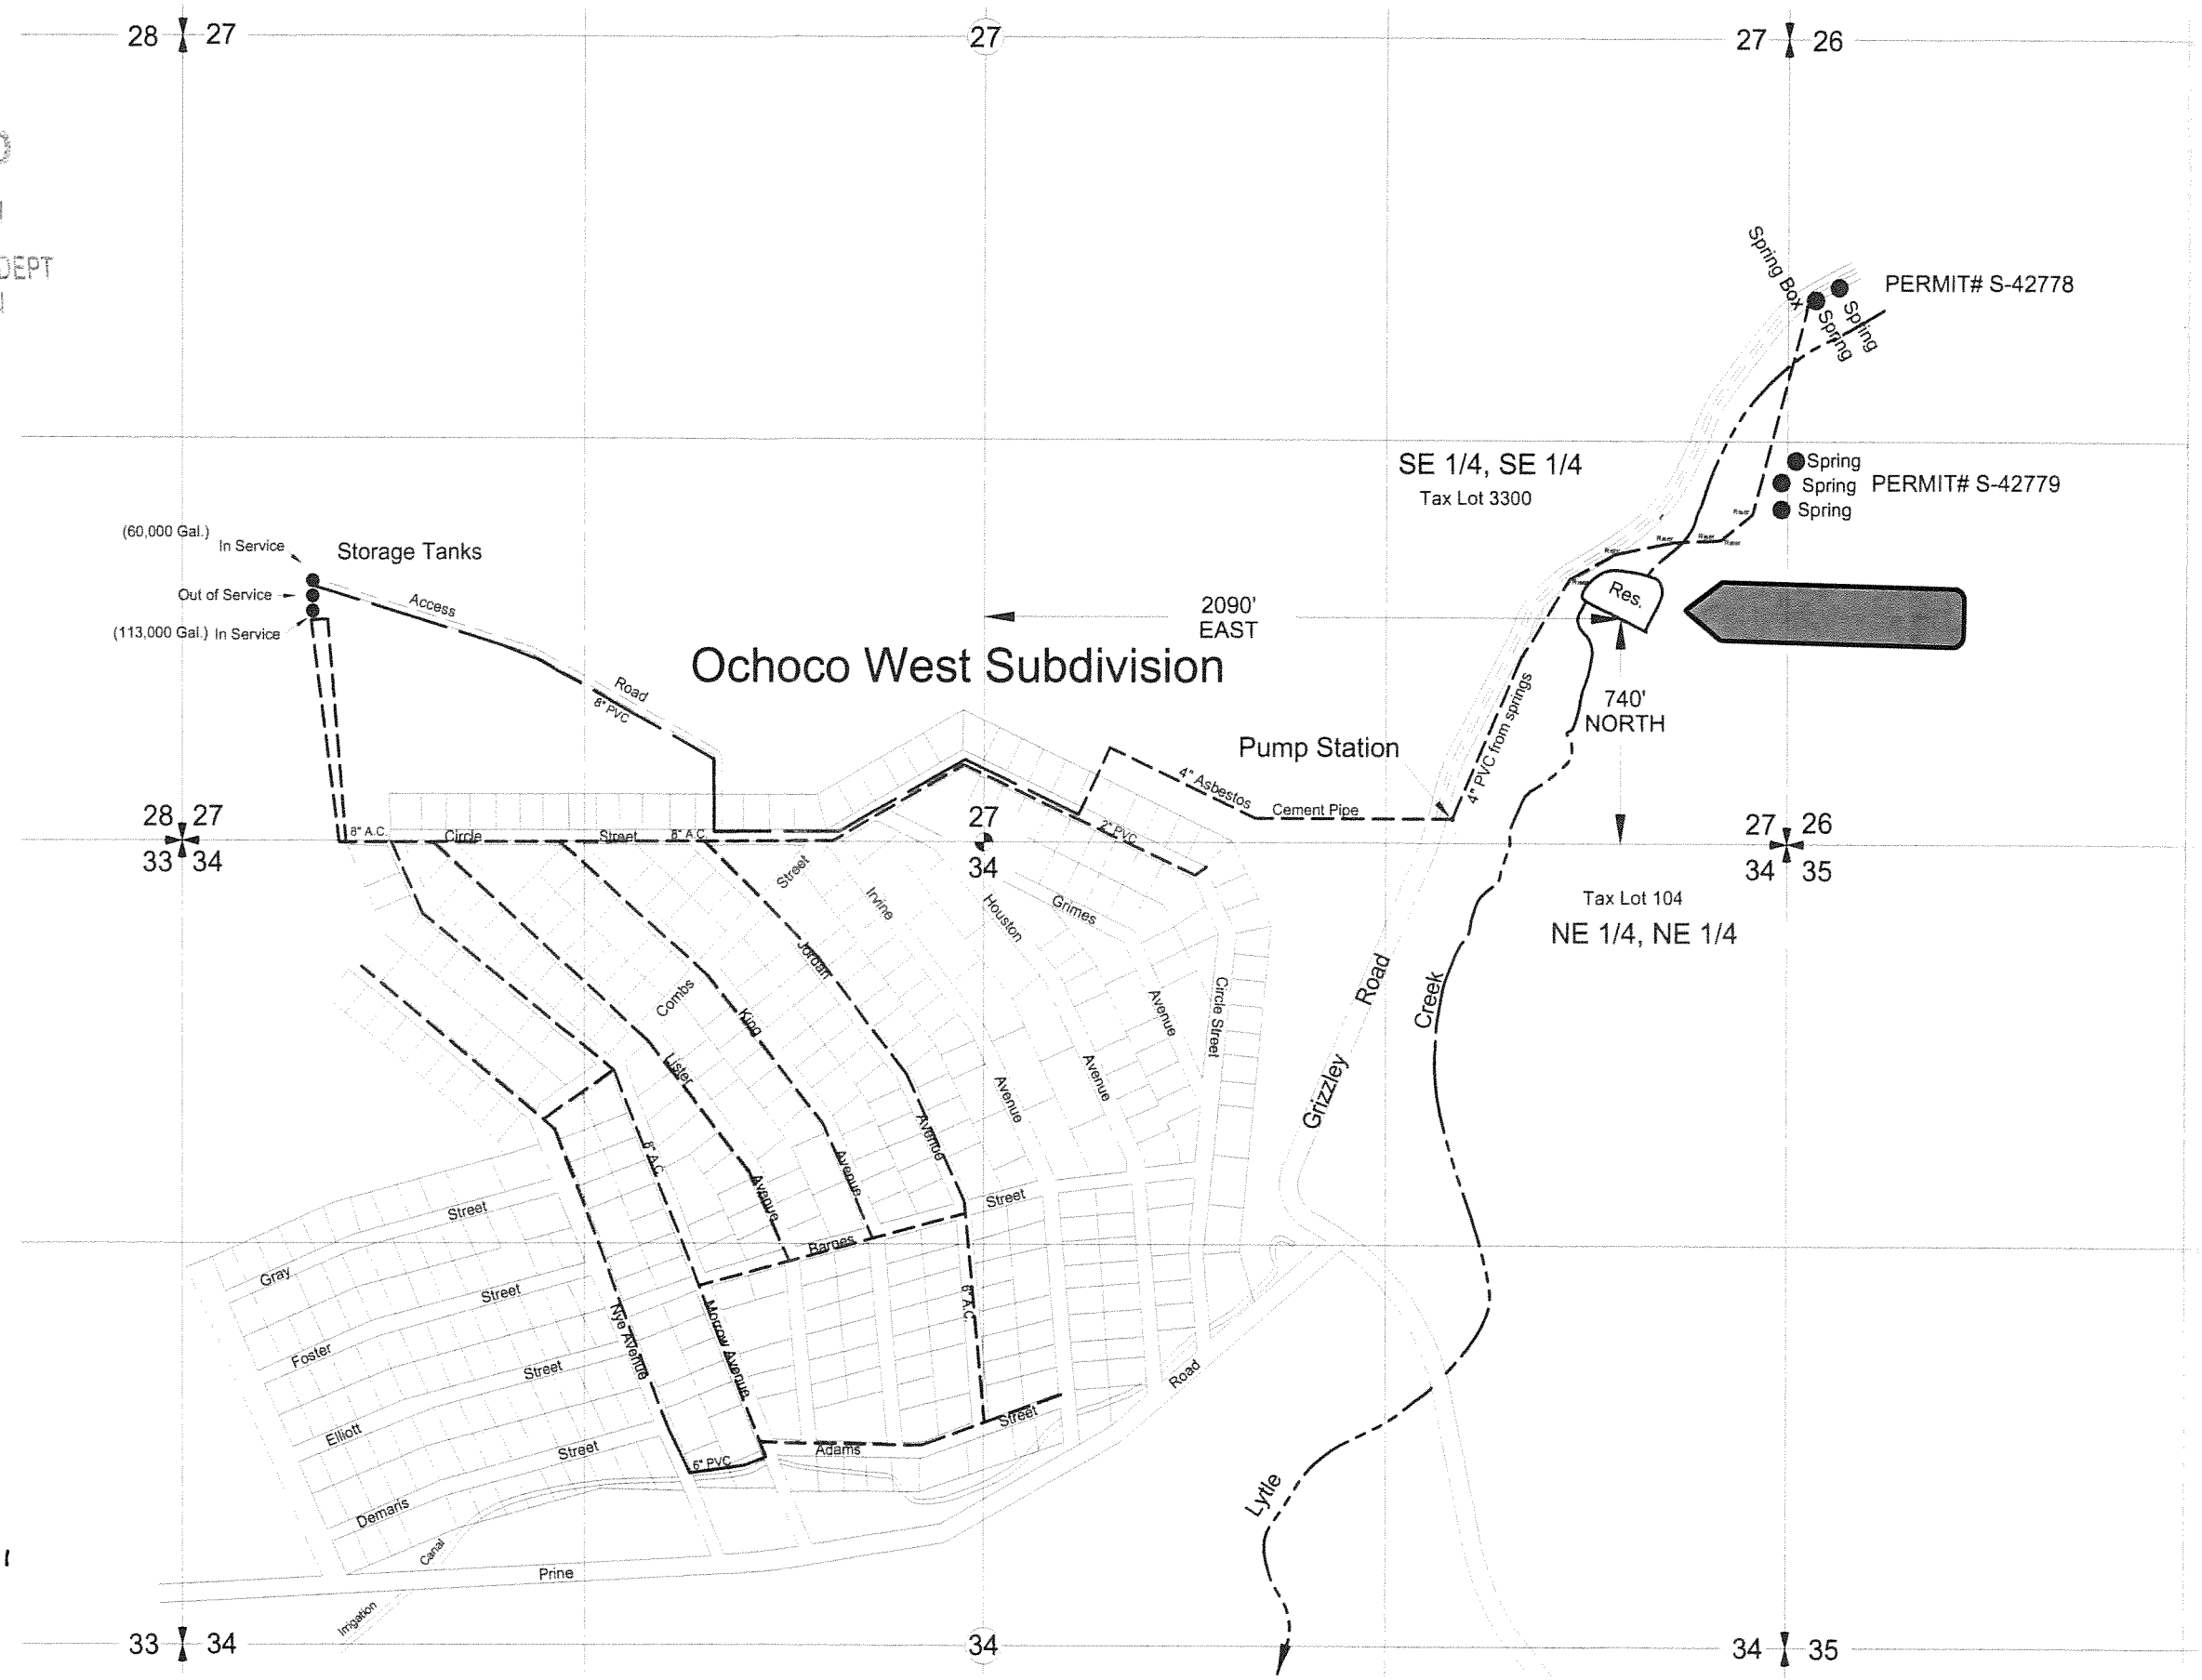

T. 13S., R. 15E., W.M.