


T. 17S., R. 20E., W. M.

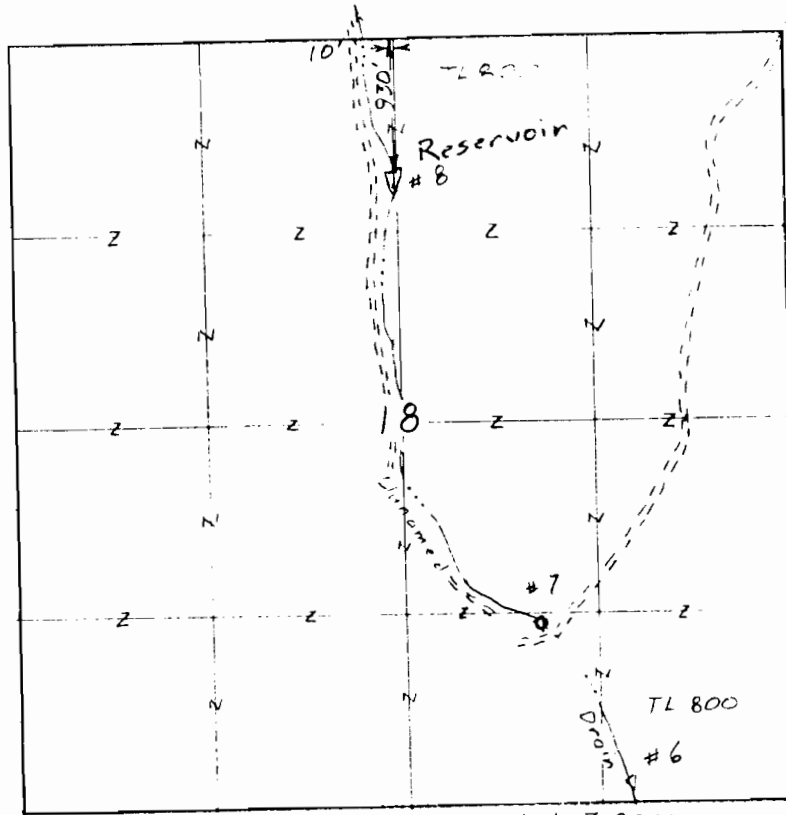

Scale 1" = 1320'  
(1" = 1 mile)



Surveyed July 7, 2011


Claim of Beneficial Use Map  
for  
SHOTGUN RANCH, LLC

App R-87090  
Per R-14636 (Res. #8)

**RECEIVED**

MAR 12 2012

WATER RESOURCES DEPT  
SALEM, OREGON

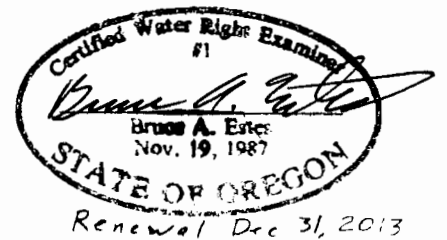

This map is for the purpose of  
locating a water right only  
and has no intent to provide  
legal dimensions or the location  
of property lines.

**ESTES SURVEYS, LLC**

PO Box 47519 60382 Arnold Rd  
Salem, OR 97306-7519 Bend, OR 97702  
(503) 586-7503 (541) 382-7391