


Williamson Reservoir
T 12S R 20E Section 15 Tax Lot 1701

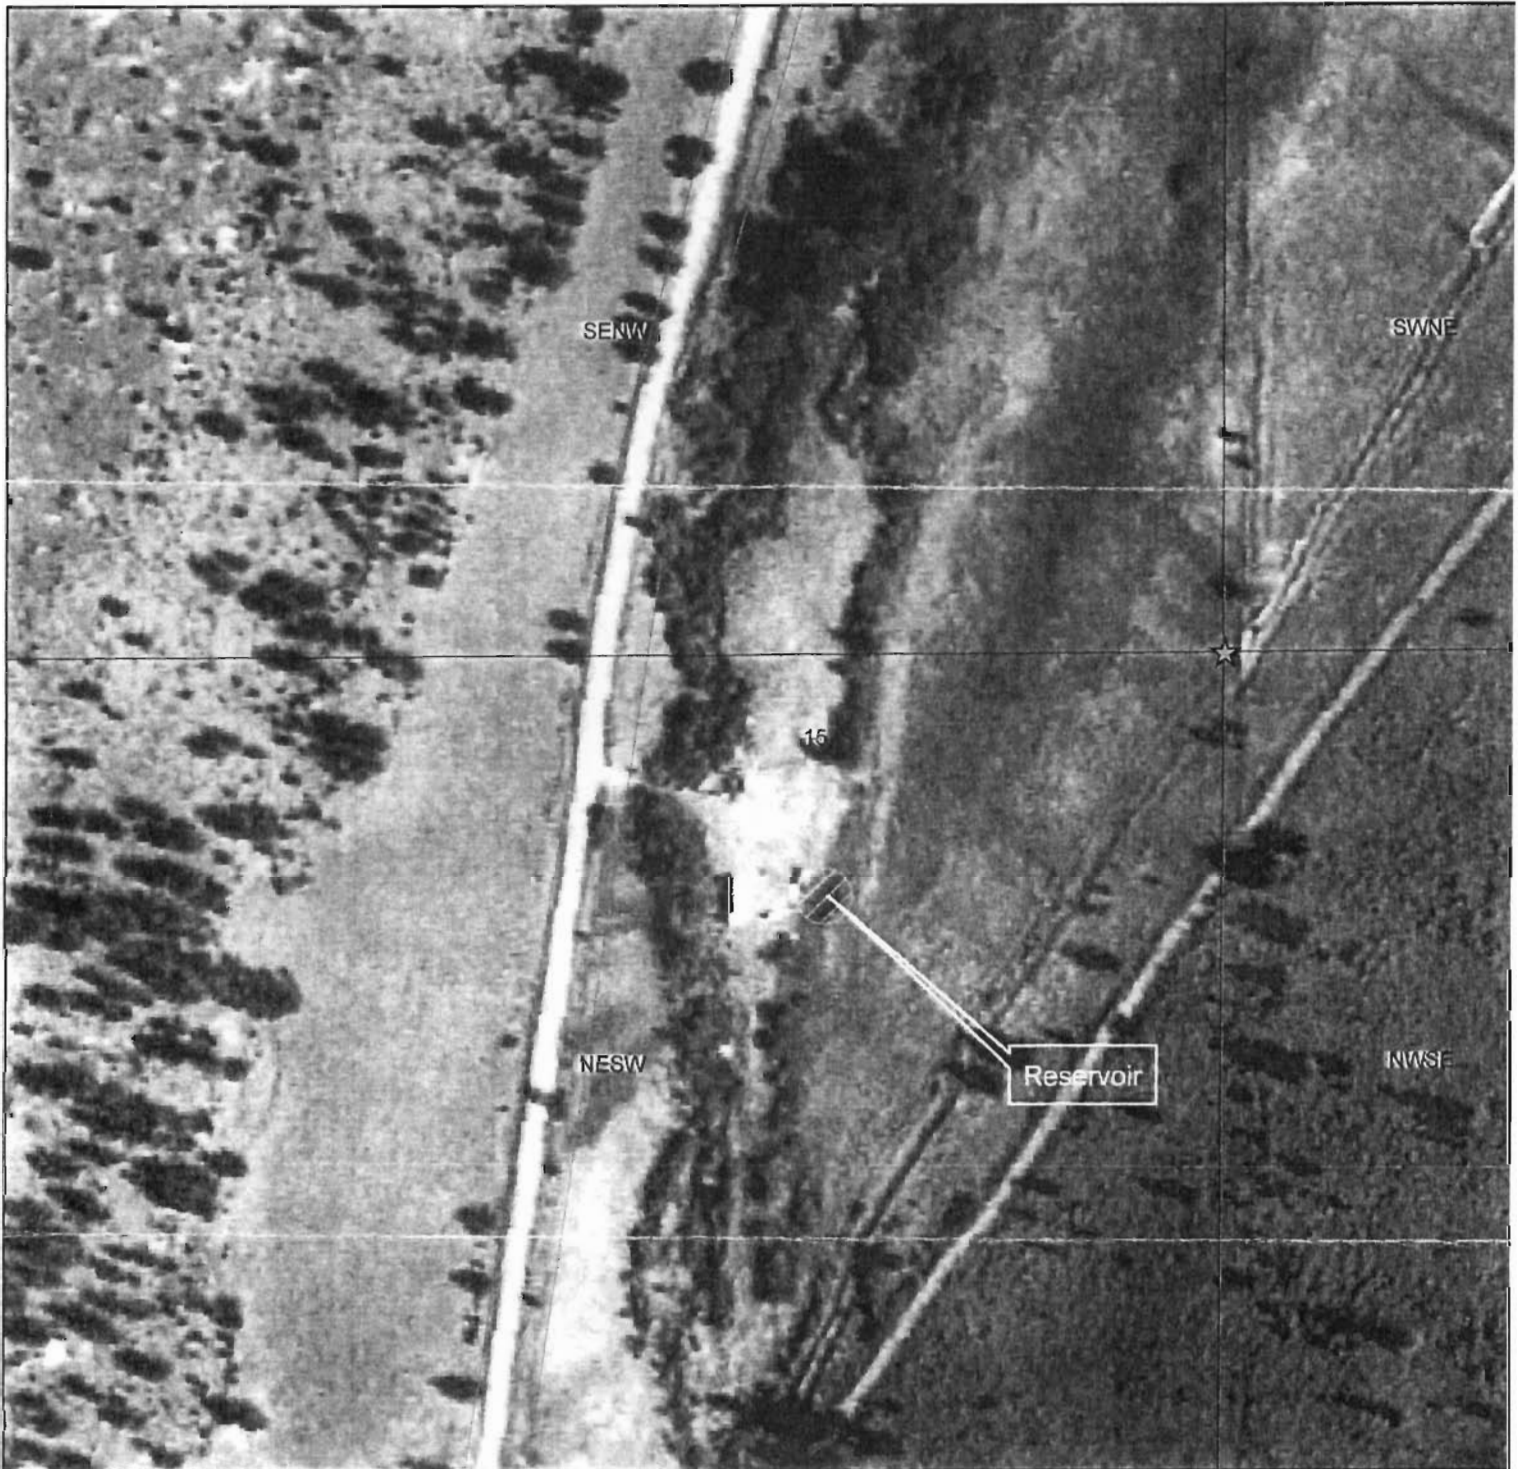

0 175 350 700 Feet

1 inch equals 200 feet

Center of Reservoir: 395 feet East and 250 Feet South of the Center of Section 15

☆ = Center of Section 15

RECEIVED

APR 15 2008

RECEIVED

APR 26 2011

WATER RESOURCES DEPT
SALEM OREGON

-OWRD GIS jtc, WMdistrict21: Williamson_080714

This product is for informational purposes and may not have been prepared for, or be suitable for legal engineering, or surveying purposes. Users of this information should review or consult the primary data and information sources to ascertain the usability of the information.

