

T. 4 S., R. 5 W., W.M.

Location: The NE 1/4 of the NE 1/4 of Section 9 and also the NW 1/4 of the NW 1/4 of Section 10, T.4 S., R.5 W., Willamette Meridian, Yamhill County, Oregon.

RECEIVED

AUG 7 2011

WATER RESOURCES DEPT
SALEM, OREGON

Tax Lot: 4509-100

Scale: 1" = 400'

Date: 1 June 2011

LEGEND:

— · — · — = Property line
— — — = D.L.C. line
— — — = Section line
— — — = "40" line

North

TO BE TRANSFERRED
permit cert.



= R-4974 R-40511
32424 40512

REMAINING PORTION
permit cert.
32424 40512




Diversion Point is S52°11'00"W 162.0'
from the NE corner of Section 9.


Existing Reservoir

I certify that the information I have provided in this application is an accurate representation of the proposed water use and is true and correct to the best of my knowledge. It is to be used for the purpose of identifying the location of water right only and is not intended to provide legal dimensions or location of the property ownership lines.

Matt Dunckel
Matt Dunckel CWRE

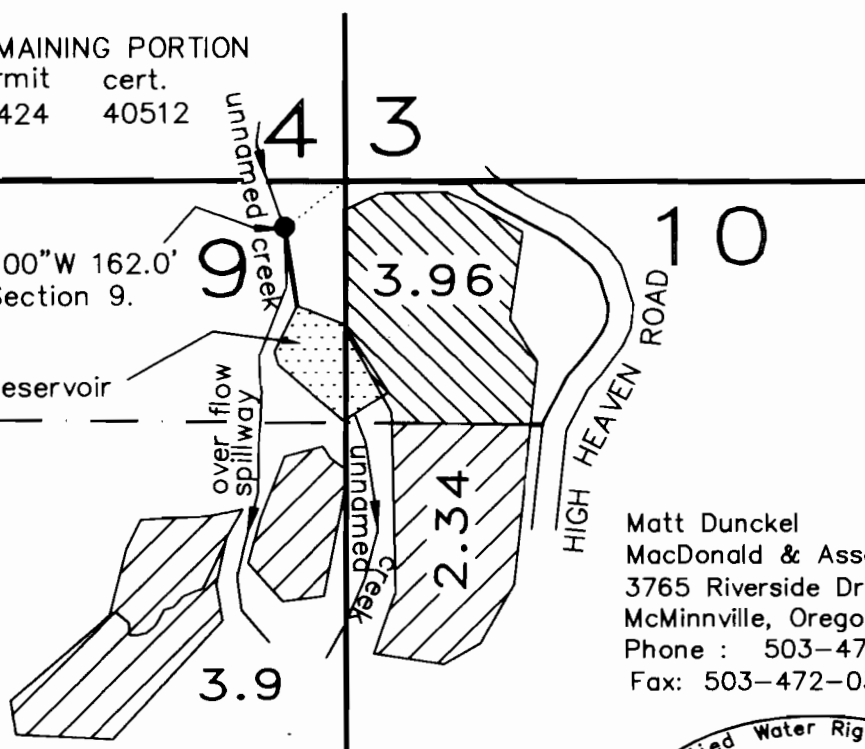

Matt Dunckel
MacDonald & Assoc.
3765 Riverside Drive
McMinnville, Oregon 97128
Phone : 503-472-7904
Fax: 503-472-0367

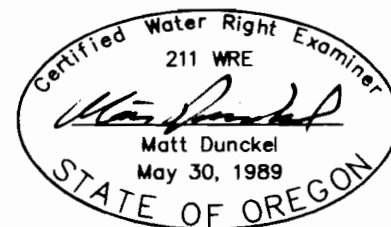

FINAL PROOF SURVEY
UNDER

Transfer Application No. T-7216 Permit No.

IN NAME OF

David J. & Joanne A. Kraemer

Surveyed June 1, 2011,