


CLAIM OF BENEFICIAL USE

TRANSFER T-10772

MAP 1 OF 2

TOWNSHIP 26 SOUTH, RANGE 5 WWEST, W.M.

Douglas County Oregon

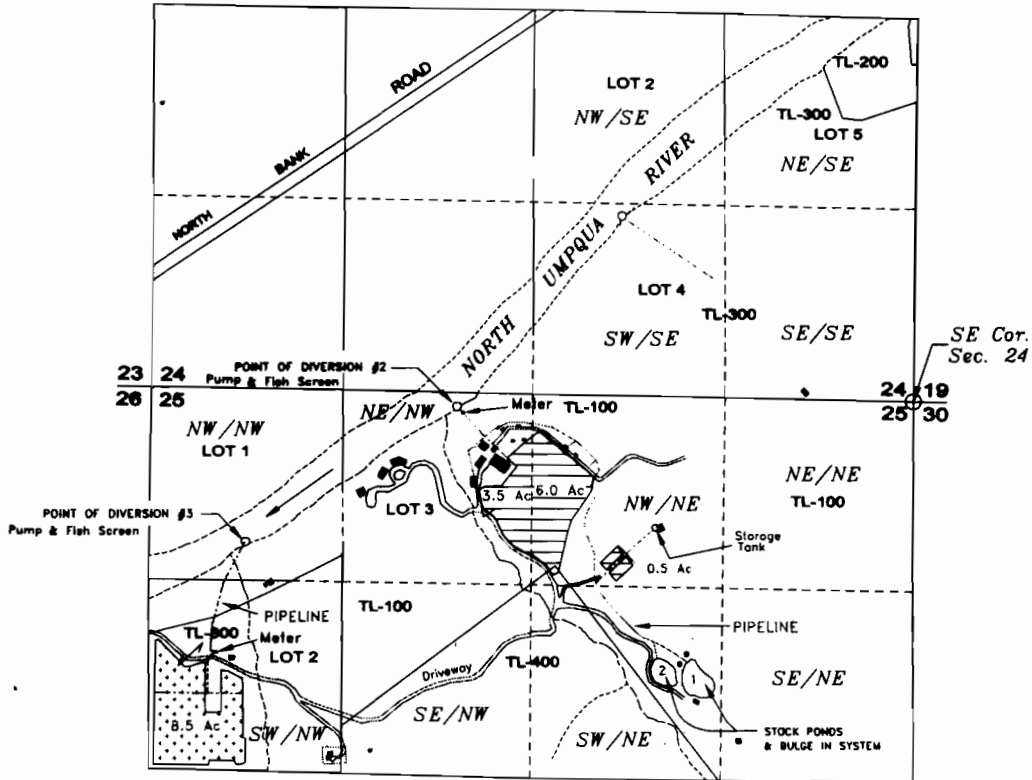

- Point of Diversion #2 - Lot 3 (NE/NW) Section 25, T26S, R5W, W.M.
100 feet South and 3130 feet West from SE corner section 24
- Point of Diversion #3 - Lot 1 (NW/NW) Section 25, T26S, R5W, W.M.
1040 feet South and 4580 feet West from SE corner section 24

RECEIVED
 WATER RESOURCES DEPT
 SALEM, OREGON


IRRIGATION



8.5 Acres - CERT. 82929



10 Acres - CERT. 80761

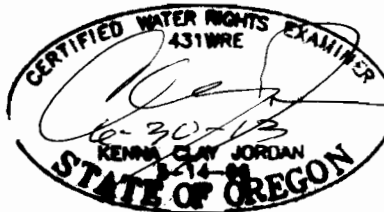

FOR:
 James W. & Jane P. Ratzlaff
 391 Stillwater Road
 Roseburg, OR 97470

Scale
 1 inch = 1320 feet



This map is not intended to provide legal dimensions or locations of property ownership lines

Base map prepared using:
 COBU map for Certificate 82929
 Assessor maps and 2005 FSA
 aerial photo overlay

Drawn 1/31/2011, n.e.d.
 Rev-1, 1/27/2012, n.e.d.
 Rev-2, 2/12/2012, n.e.d.

JORDAN ENGINEERING
 460 JORDAN LANE
 ROSEBURG, OR 97471
 (541) 673-1931